U.S. PUBLIC LAND SURVEY MONUMENT RECORD

Note: This form is intended and designed to fulfill all requirements of Wisconsin Administrative Code, Chapter A-E 5.02, U.S. Public Land Survey Monument Record (3) (a) (b) (c) (d) (e) (f) (g) (h) (i). An additional sheet may be added if necessary to conform with said requirements.

(a) Corner location: Township 38 North

Range 7 East/~~West~~

Town/~~City/Village~~ Lake Tomahawk

County Oneida

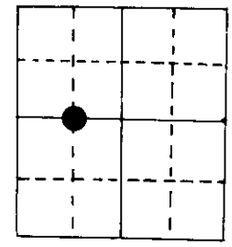

Section 22

(b) (f) (g) (h) Description of monument found at this corner and if it was accepted, state all evidence (material, testimonial, occupational, plats, records, other monuments) used as a basis for accepting. If not accepted or if nothing was found, state evidence used as basis for establishing location. If reestablished through lost corner proportionate methods, indicate all monuments, distances and directions used to establish.

Set by F.A. Winsentsen in 1949 a t midpoint on line between W¼ and wood post he found for C¼. This C¼ wood post is in wrong location.
BT's he made asp 12" N 32°E 6½ lks., mpl 7" N 39°W 23 lks.

Seymour, 1987, set correct location by subdivision of section 22.

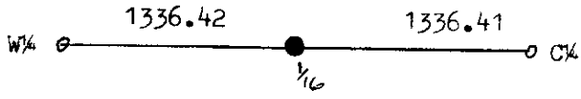

erroneous 1/16 is S20°12'47"W 64.16' from correct CW 1/16.

(c) (d) (e) Plan view of corner with ties to at least 4 witness monuments. If in disagreement with previously established corner, show the distances between the two corners and also indicate the ties to the disputed corner.

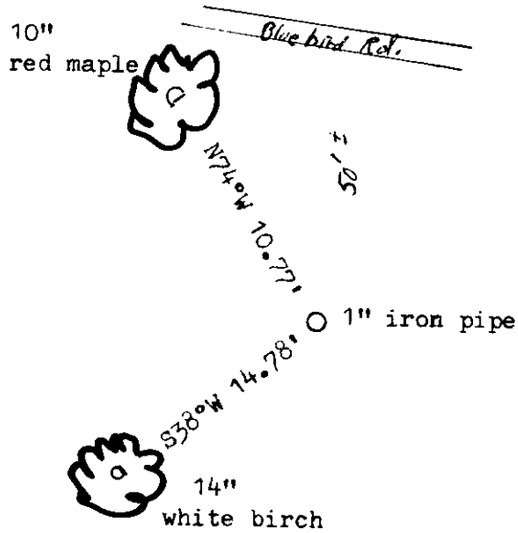

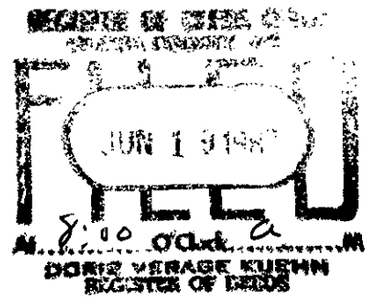

(i) I, Marvin E. Seymour (type or print name) certify that the corner location on this record was determined by me or under my direction and control and that this U.S. Public Land Survey Monument Record is correct and complete to the best of my knowledge and belief.

Affix seal here

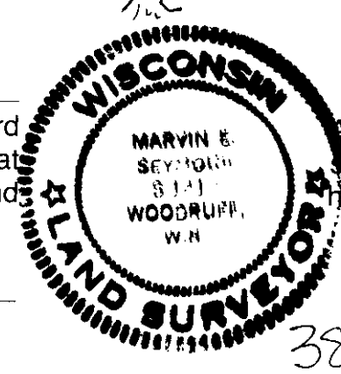

Marvin E. Seymour — June 12, 1987

Signature — Date

D-14

3807222030