U.S. PUBLIC LAND SURVEY MONUMENT RECORD

Note: This form is intended and designed to fulfill all requirements of Wisconsin Administrative Code, Chapter A-E 7.08 U.S Public Land Survey Monument Record (3) (a) (b) (c) (d) (e) (f) (g) (h) (i). An additional sheet may be added if necessary to conform with said requirements.

(a) Corner location: Township 38 North

Range 7 East/West

Town/City/Village ONEIDA

County NEWBOLD

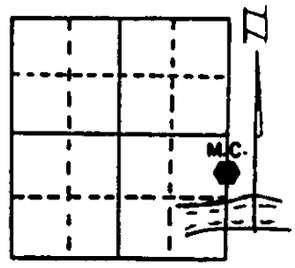

Section 25

(b) (f) (g) (h) Description of monument found at this corner and if it was accepted, state all evidence (material, testimonial, occupational, plats, records, other monuments) used as a basis for accepting. If not accepted or if nothing was found, state evidence used as basis for establishing location. If reestablished through lost corner proportionate methods, indicate all monuments, distances and directions used to establish. Indicate type of monument found or set and sign post.

1860- Alfred Miller set meander corner and made the following B.T.'s: Maple 10" N 75° W 25 Links, Elm 8" N 68° E 82 Links.

1916- Vaughan set M.C. from stumps of original trees but had to set 41 Links North of where it belongs on account of flowage.

1971- Edward H. McNown found iron pipe for M.C. on North side of Wisconsin River.

1997- William E. Bandow replaced wood post with Oneida County Monument and witnessed as shown below.

(c) (d) (e) Plan view of corner with ties to at least 4 witness monuments. If in disagreement with previously established corner, show the distances between the two corners and also indicate the ties to the disputed corner.

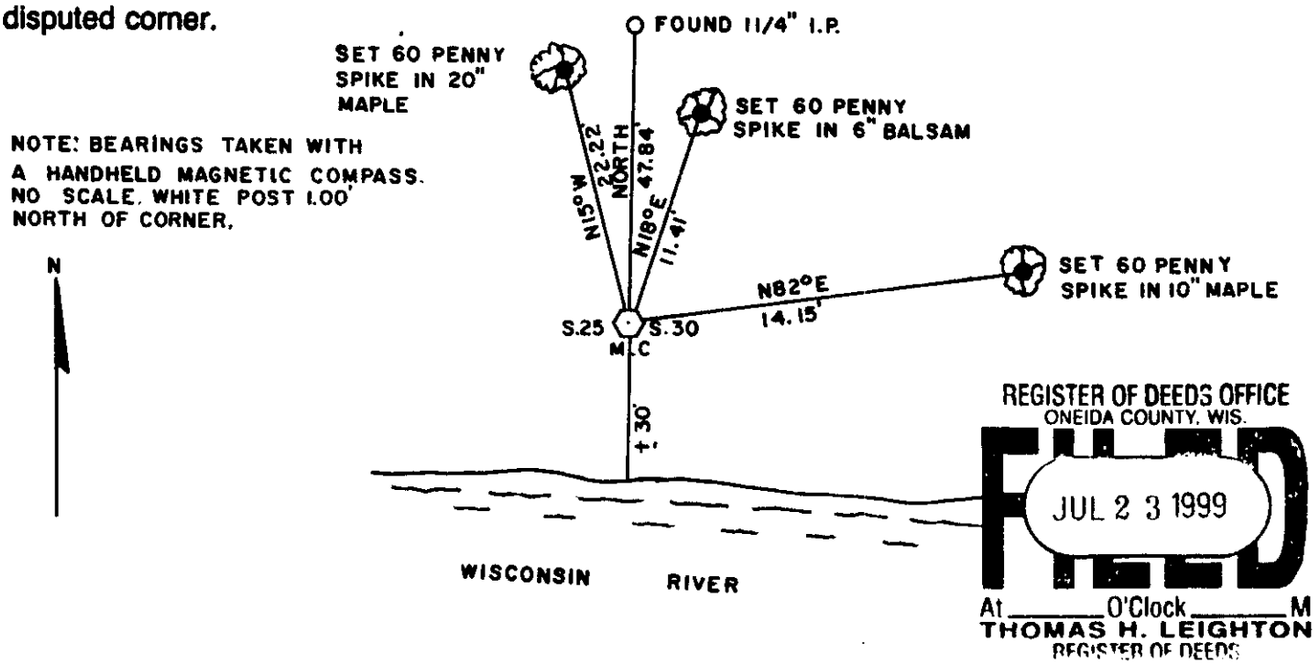

REGISTER OF DEEDS OFFICE
ONEIDA COUNTY, WIS.
FILED
JUL 2 3 1999
At _____ O'Clock _____ M
THOMAS H. LEIGHTON
REGISTER OF DEEDS

(i) I, William E. Bandow (type or print name) certify that the corner location on this record was determined by me or under my direction and control and that this U.S. Public Land Survey Monument Record is correct and complete to the best of my knowledge and belief.

William E. Bandow 7-20-99

Signature Date

WISCONSIN
WILLIAM E. BANDOW
S-1182
RHINELANDER, WI
LAND SURVEYOR

Stamp

Index No. TU 25
3807251200