


**U.S. PUBLIC LAND SURVEY MONUMENT RECORD**

Note: This form is intended and designed to fulfill all requirements of Wisconsin Administrative Code, Chapter A-E 7.08 U.S. Public Land Survey Monument Record (3)(a-i).

(a) CORNER LOCATION  
 Wit. Cor. of Secs. 23, 24, 25 & 26  
 Township 38 North  
 Range 7 East of the 4th P.M.  
 Town of Lake Tomahawk  
 County of Oneida

WISCRS - Oneida County  
 N: 209,396.76 USft  
 E: 223,650.41 USft  
 Datum: NAD 83(2011) ep. 2010.00  
 GNSS Method: RTN - Direct  
 GNSS Control: WISCORS VRS

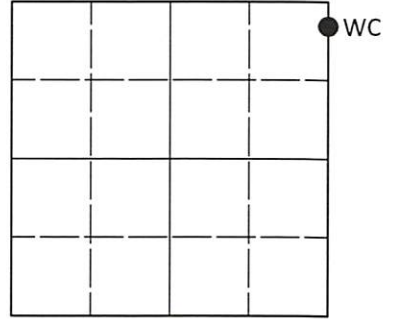

Sec. 26, T. 38 N., R. 7 E.

(b)(f)(g)(h) Description of monument found at this corner and if it was accepted, state all evidence (material, testimonial, occupational, plats, records, other monuments) used as a basis for accepting. If not accepted or if nothing was found, state evidence used as basis for establishing location. If re-established through lost corner proportionate methods, indicate all monuments, distances and directions used to establish. Indicate type of monument and sign post found or set.

*This record is a perpetuation of a monument of the following land corner document(s):*


*Feb. 28, 1986: USPLS Monument Record by William E. Bandow, filed in Oneida County*

*A complete history of the corner can be found on the previous land corner document(s). I accept the record activity as a true and faithful perpetuation or reestablishment of the original corner location and further perpetuate it as described below.*

*Jan. 17, 2022: I found and accepted the record monument, a 1.8" diam. iron pipe, firmly set, projecting 2" above the ground surface. I found or established accessories as indicated below. I found a white vinyl sign post bearing Southwest, 0.7 ft.*

*The coordinate value shown has been verified by averaging two or more GNSS observations at markedly different times.*

(c)(d)(e) Plan view of corner with ties to at least 4 witness monuments. If in disagreement with previously established corner, show the distances between the two corners and also indicate the ties to the disputed.

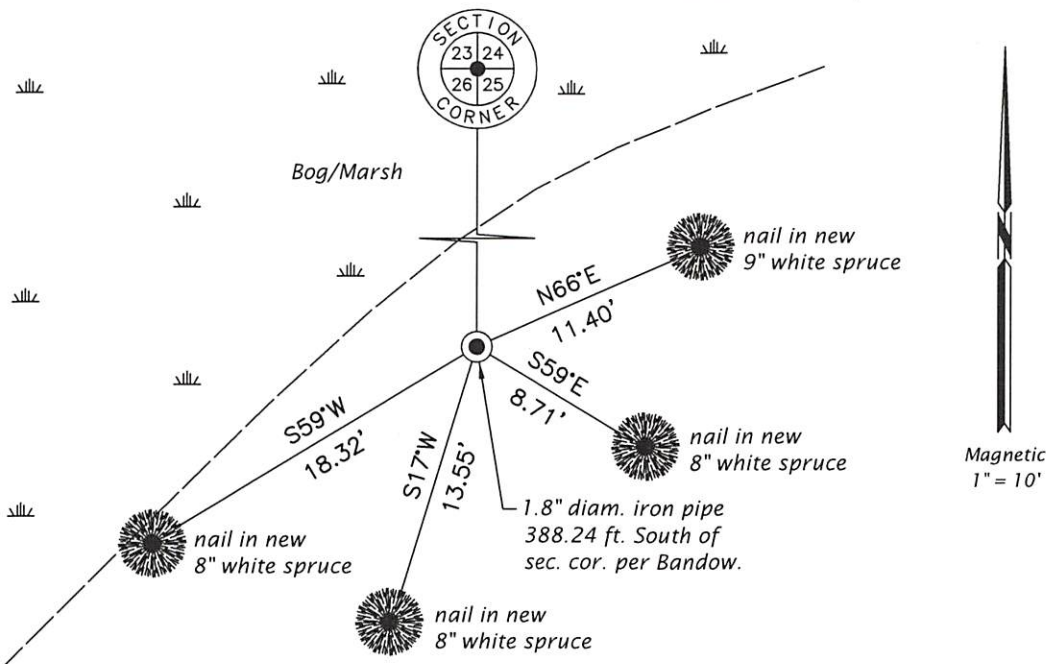

Magnetic  
1" = 10'

REGISTER OF DEEDS OFFICE  
 ONEIDA COUNTY  
 FILED

MAR 07 2022

KYLE J. FRANSON  
 REGISTER OF DEEDS

(i) I, Jeffrey W. Austin, Professional Land Surveyor No. S-1885, hereby certify that the corner location on this record was determined by me or under my direction and control and that this U.S. Public Land Survey Monument Record is correct and complete to the best of my knowledge and belief.

*[Handwritten Signature]*  
 Signature

FEB. 22, 2022  
 Date