

CERTIFIED LAND CORNER RESTORATION

State of Wisconsin }  
County of Oneida } ss.

we I, Gerald B. Inman, do hereby certify that on the 12th day of June, 1981, ~~we~~ found evidence of the Northwest section corner of Section 33 Township 38 North, Range 7 East, Fourth Principal Meridian, as described hereon; and that ~~from this evidence~~ we established ~~a new monument and~~ accessories as described hereon to perpetuate the original location of this corner:

Description of original monument and accessories and subsequent restorations:


- Wood post
- 10" Aspen, S53 1/2°E, 7 links
- 10" Aspen, S36°W, 9 links

Description of corner ~~evidence~~ found:

- W.C.D. brass capped iron pipe

Description of ~~monument and~~ accessories ~~we~~ established to perpetuate the location of this corner:

- W.C.D. brass capped iron pipe
- No bearing trees

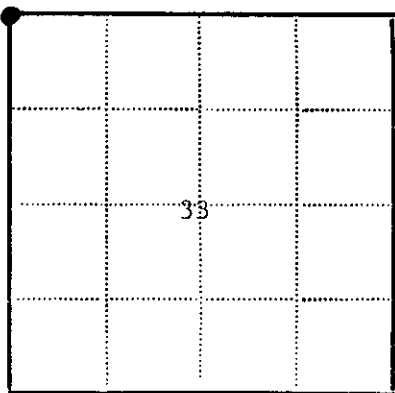

- - Corner monument restored
- -

~~Resident~~ witnesses Robert W. Conner, Jr.

Dated at Minocqua Wisconsin, this 12th day of June 1981.

Signature *Gerald B. Inman* Title R.L.S.  
(County Surveyor, Registered Land Surveyor, or other duly authorized official)

Surveyors Registration No. S-891

Office of *Reg. of Deeds* County of *Oneida*, I hereby certify that the within instrument was filed in this office for record on the *11* day of *June* 1981, and was filed in Book No. \_\_\_\_\_ Page No. \_\_\_\_\_ of County Records.

Signature *Doris Verage Kuehn* Title *Reg. of Deeds*  
*Cynthia A. Witts Deputy*

Township \_\_\_\_\_, Range \_\_\_\_\_, Section \_\_\_\_\_, Index No. \_\_\_\_\_, Page No. \_\_\_\_\_

3807290000

6-1