U.S. PUBLIC LAND SURVEY MONUMENT RECORD

Note: This form is intended and designed to fulfill all requirements of Wisconsin Administrative Code, Chapter A-E 7.08 U.S. Public Land Survey Monument Record (3) (a) (b) (c) (d) (e) (f) (g) (h) (i). An additional sheet may be added if necessary to conform with said requirements.

(a) Corner location: Township 37 North

Range 7 East/West

Town/~~City/Village~~ Cassian

County Oneida

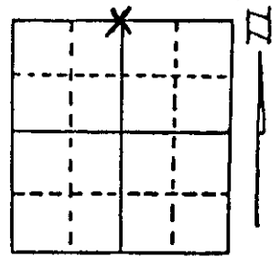

(b) (f) (g) (h) Description of monument found at this corner and if it was accepted, state all evidence (material, testimonial, occupational, plats, records, other monuments) used as a basis for accepting. If not accepted or if nothing was found, state evidence used as basis for establishing location. If re-established through lost corner proportionate methods, indicate all monuments, distances and directions used to establish. Indicate type of monument found or set and sign post.

9/8/1860 - Alfred Millard established corner at 40.00 chains and set a wood post:
14" Black Oak, S62°E, 9 links 14" Black Oak, N69°W, 20 links

1900(+ or -)- Dorr made two BTs:
12" Soft Maple, N84°W, 52 1/2 links (33.65') 8" Sugar Maple, N3°W, 6 1/2 links(4.29')

9/21/1936 - V. Maine found stub of original BT, N69°W, 20 links and Dorr's BTs. He set county monument and made new BTs:
12" White Pine, N62°E, 96 1/2 links 4½" Black Oak, N16°W, 19½ links
4½" Black Oak, S51°W, 28 links

2/15/1989 - Milo E. Stefan found county monument in good condition with many BTs. Old fence corner with fences south and east.

(c) (d) (e) Plan view of corner with ties to at least 4 witness monuments. If in disagreement with previously established corner, show the distances between the two corners and also indicate the ties to the disputed corner.

1. County Monument 2" x 60" Iron Pipe/Brass Cap
2. 20" White Pine, N62°E, 63.8' (Maine)
3. 9" Red Oak, N75°E, 14.3' (Rein)
4. 8" Red Oak, S40°-48'W, 107.3' (Foltz)
5. 6" Red Oak, S50°W, 18.0' (Maine)
6. 9" Red Oak, S82°W, 27.9' (Rein)
7. 18" Red Maple, N84°W, 34.6' (Dorr)
8. 12" Red Oak, N17°W, 12.6' (Maine)
9. 12" Maple Snag, N17°W, 4.3' (Dorr)
10. Plastic Sign Post.

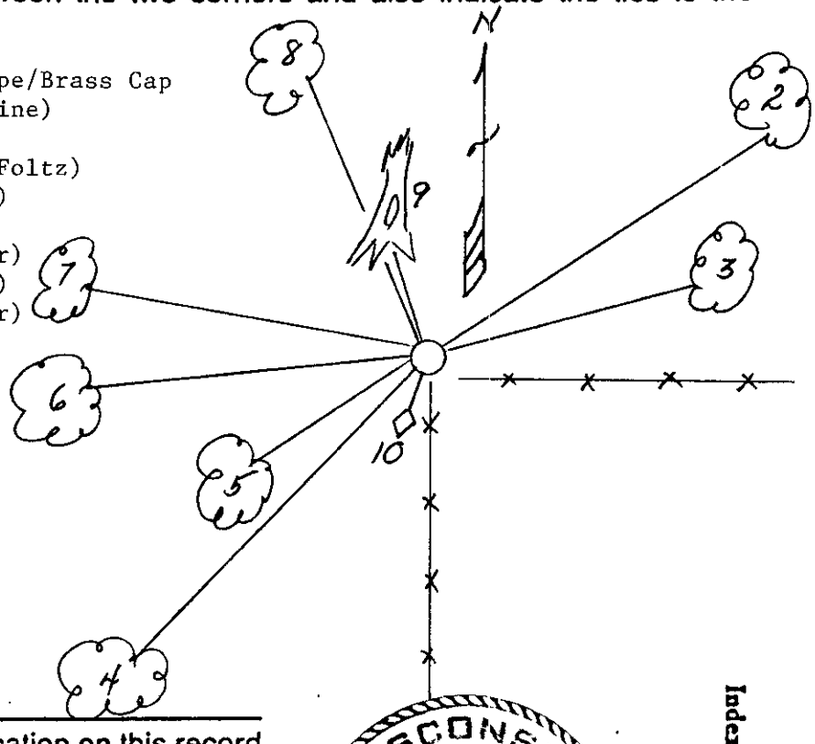

(i) I, Milo E. Stefan (type or print name) certify that the corner location on this record was determined by me or under my direction and control and that this U.S. Public Land Survey Monument Record is correct and complete to the best of my knowledge and belief.

Milo E. Stefan 2/16/89

Signature Date

WISCONSIN MILO E. STEFAN S-1033 RHINELANDER, WIS. LAND SURVEYOR

Index No. A-15

38073402O