

CERTIFIED LAND CORNER RESTORATION

Index No. **Y-24**

State of Wisconsin

County of **Oneida** } ss.

I **Phillip T. Hansen**, do hereby certify that on the **13th** day of **January**, 19 **77**, I found evidence of the **SE 1/16** corner of **Section 36**


Township **38**, North, Range **7 East**, Fourth Principal Meridian,

as described hereon; and that from this evidence I established a new monument and accessories as described hereon to perpetuate the original location of this corner.


Resident witnesses:

Jim Clarlin

Herb Wagoner

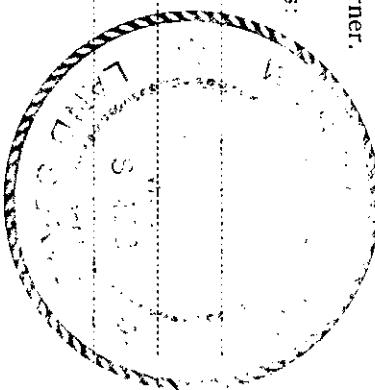

T38N R7E

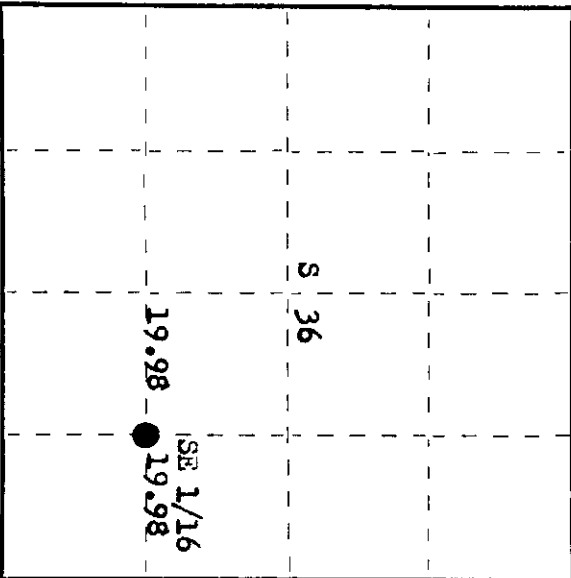

○ = Corner monument restored.

History of original corner establishment.

Corner established by Goddard and crew, Ripco surveyors, in 1959. From established SC 1/16 corner, ran on bearing 86° 42' mag. 39.96 chains to close out 1.25 chains south of S 1/16 corner. Set SE 1/16 at 19.98 chains and 62 1/2 links north. Set iron pipe and marked BTs - White Pine 6" N 37° E 40 links and Tamarack 6" N 27° W 57 links.

Description of corner evidence found:

Recovered 1" iron pipe with 2" brass cap, not stamped.

Monument was found in good condition and securely in ground.

Recovered White Pine 6" (10") N 37° E 40.0 links (39.0 links), scribing not legible. Tamarack 6" N 27° W 57.0 links, scribed SE 1/16 BT. Now a dead snag.

Description of monument and accessories I established to perpetuate the original location of this corner.

The brass cap was stamped:

Monument projects 20" above ground.

NBT - Jack Pine 8" N 76° E 26.0 links, scribed 1/16 BT.

T38N R7E
SE 1/16 S 36

Dated at **Rhinelander**, Wis., this **18th** day of **January**, 19 **77**.

Signature *Phillip T. Hansen* Title **Registered Land Surveyor** Registration No. **S-498**
(County Surveyor, Registered Land Surveyor, or other duly authorized official)

Office of Register of Deeds, County of **Oneida**. I hereby certify that the within instrument was filed in this office for record on the **24th** day of **February**, 19 **77** at **1:00** o'clock **P.** M.

Devin Verage Kuehn
(Register of Deeds)

By _____ Deputy

3807361010