

CERTIFIED LAND CORNER RESTORATION

Index No. **X-25**

State of Wisconsin

County of **Oneida**

ss.

I, **Philip T. Hansen**, do hereby certify that on the **25th** day of **February**, 19 **77**, I found evidence of the **Quarter** corner of **Sec. 36 & 31**



Township **38**, North, Range **7 & 8 East**, Fourth Principal Meridian,

as described hereon; and that from this evidence I established a new monument and accessories as described hereon to perpetuate the original location of this corner.

Resident witnesses:

Jim Clarlin

Herb Wagoner

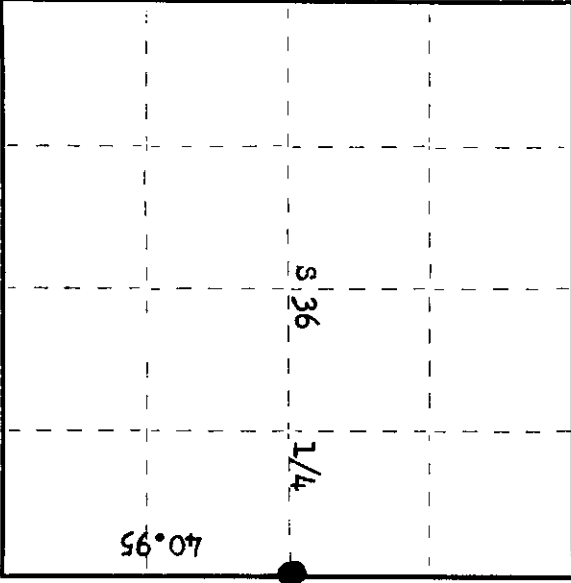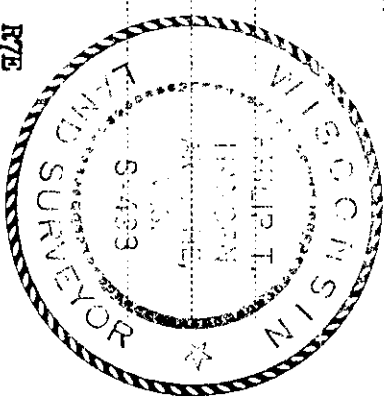

○ = Corner monument restored.

History of original corner establishment:

Corner re-established by B.F. Dorr, County Surveyor. Corner recovered by N. Loftus, Ripco Surveyor, in 1959. Ran random line bearing **357° 28' mag.**, closed out at **80.31 chains** 4 links east of recovered NE corner. Recovered old stake at **40.95 chains** 2 links west. Marked NBTs - Tamarack 6" **S63°E**, 31 links and Tamarack 8" **S82°W**, 49½ links.

Description of corner evidence found:

Recovered **1½"** iron pipe with **3"** square brass cap in good condition and securely in ground. Cap stamped:
Recovered OBTs - Tamarack 8" **S82°W** (**S84°W**) **49½** links (**48.5** links), scribed **E 1/4 S36 BT.**
Tamarack 8" **S63°E** (**S60°E**) **31** links (**30.5** lks), scribed **W 1/4 S31 BT.**



Description of monument and accessories I established to perpetuate the original location of this corner.

As monument was recovered in good condition, it was left in place. Added stamping **T38N R7E-R&L** to brass cap. Monument projects **30"** above ground. NBT - Tamarack 9" **N10°W** **66.6** links, scribed **1/4** BT.

Dated at **Rhinelander**, Wis., this **28th** day of **March**, 19 **77**.

Signature *Philip T. Hansen* Title **Registered Land Surveyor** Registration No. **3498**
(County Surveyor, Registered Land Surveyor, or other duly authorized official)

Office of Register of Deeds, County of **Oneida**
at **1:30** o'clock **P**M. **1st** day of **April**, 19 **77**

Terese Marie Krasinski
(Register of Deeds)

By: _____ Deputy

380736200