

CERTIFIED LAND CORNER RESTORATION

Index No. **X-24**

State of Wisconsin

County of Oneida } ss.

I, Phillip T. Hansen, do hereby certify that on the 25th day of March, 19 77, I found evidence of the E-C 1/16 corner of Section 36


Township 38, North, Range 7 East, Fourth Principal Meridian,

as described hereon; and that from this evidence I established a new monument and accessories as described hereon to perpetuate the original location of this corner.

Resident witnesses:

Jim Clafin


Herb Wagoner

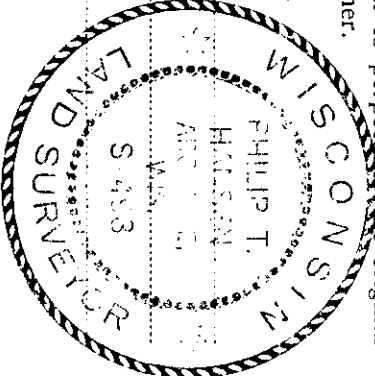

T38N R7E

EC 1/16

S 36 19.905 19.905

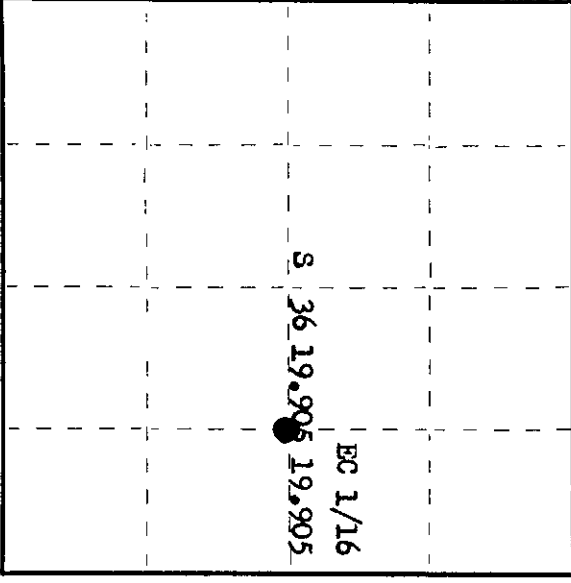

History of original corner establishment:

Corner established by N. Loftus, Ripco Surveyor. Ran a random line east from W 1/4 corner 79.69 chains to close out 1.774 chains south of E 1/4 corner. Established C 1/4 corner at 39.88 (Dorr's Corner) and set EC 1/16 at 59.785 chains intermediate. Marked BT - Tamarack 3" N18°E 72 links. No other suitable trees available.

Description of corner evidence found:

Recovered 1" iron pipe with 2" square brass cap in good condition and securely in ground. Cap stamped:

Recovered 0BT - Tamarack 3" N18°E 72 links, scribed CE 1/16 S36 BT.

CE 1/16  
RIPCO

Description of monument and accessories I established to perpetuate the original location of this corner.

As the monument was recovered in good condition, it was left in place.

Added stamping T38N R7E to brass cap.

Monument projects 20" above ground.

NET - Tamarack 6" S32°W, 132.0 links, scribed 1/16 BT.

Dated at Rhineland, Wis., this 28th day of March, 19 77

Signature Phillip T. Hansen Title Registered Land Surveyor Registration No. S-498  
(County Surveyor, Registered Land Surveyor, or other duly authorized official)

Office of Registrar of Deeds, County of Oneida  
Instrument was filed in this office for record on the last day of April, 19 77  
at 1:00 o'clock P. M. I hereby certify that the within

James George Kuehn  
(Register of Deeds)

By James George Kuehn Deputy

3807362010