


U.S. PUBLIC LAND SURVEY MONUMENT RECORD

Note: This form is intended and designed to fulfill all requirements of Wisconsin Administrative Code, Chapter A-E 7.08 U.S. Public Land Survey Monument Record (3) (a) (b) (c) (d) (e) (f) (g) (h) (i). An additional sheet may be added if necessary to conform with said requirements.

(a) Corner location: Township 38 North
 Range 8 East West

Town/City/Village Newbold

County Oneida

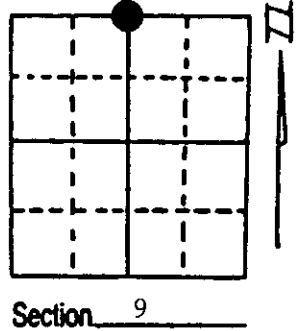

(b) (f) (g) (h) Description of monument found at this corner and if it was accepted, state all evidence (material, testimonial, occupational, plats, records, other monuments) used as a basis for accepting. If not accepted or if nothing was found, state evidence used as basis for establishing location. If reestablished through lost corner proportionate methods, indicate all monuments, distances and directions used to establish. Indicate type of monument found or set and sign post.

1868 - Alexander Anderson established this corner by setting a wood post with two BTs:
 16" White Pine, N40°W, 9 Links 14" White Pine, S55°E, 24 Links


1990 - Kip Soder restored corner and placed a Oneida County aluminum monument with BTs.
 No record of this is on file.

11/9/1994 - Milo E. Stefan accepts this position and took bearings and distances to the BTs and placed a plastic sign post.

(c) (d) (e) Plan view of corner with ties to at least 4 witness monuments. If in disagreement with previously established corner, show the distances between the two corners and also indicate the ties to the disputed corner.


- 1) 2" x 36" Aluminum Monument.
- 2) 8" Red Oak, N75°E, 15.99'.
- 3) 8" Red Oak, S14°E, 6.85'.
- 4) 12" Red Oak, N72°W, 29.00'.
- 5) 12" Red Oak, N41°W, 37.57'.
- 6) Plastic Sign Post, SW, 0.5'.

Distances to nail in side of BTs.
 Stump blazes scribed "BT".

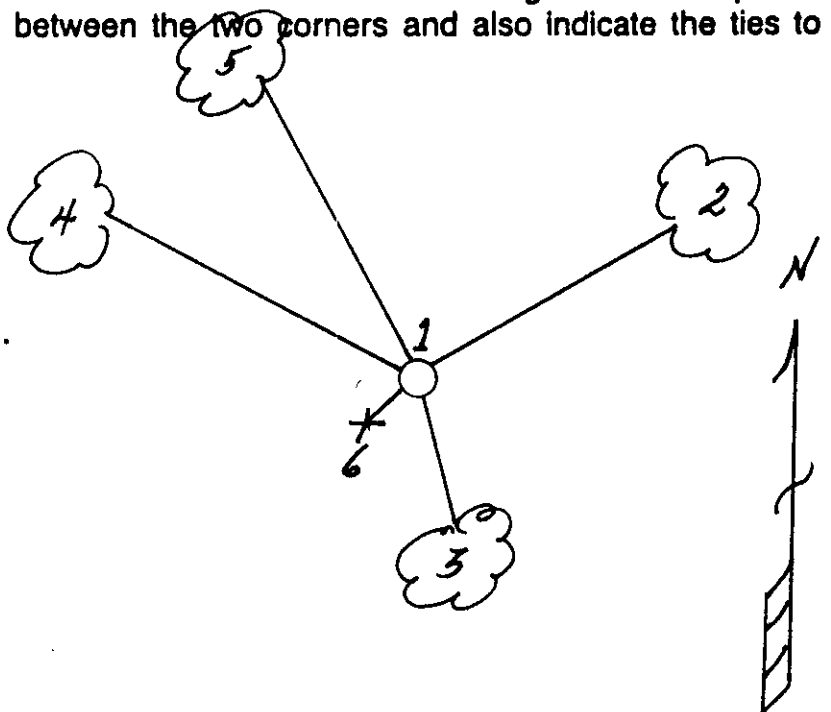

(i) I, Milo E. Stefan
 (type or print name) certify that the corner location on this record was determined by me or under my direction and control and that this U.S. Public Land Survey Monument Record is correct and complete to the best of my knowledge and belief.

Milo E. Stefan November 21, 1994
 Signature Date

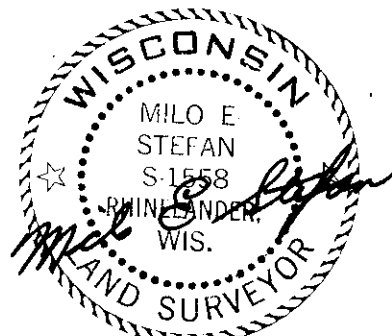

Index No. E-11

3808040020