

CERTIFIED LAND CORNER RESTORATION

State of Wisconsin }
County of Oneida } ss.

I Michael J. Romportl, do hereby certify that on the 30 day of September, 1981, I found evidence of the Northeast corner of Section 18 Township 33 North, Range 3 East, Fourth Principal Meridian, as described hereon; and that from this evidence I established a new monument and accessories as described hereon to perpetuate the original location of this corner:

Description of original monument and accessories and subsequent restorations:

- 1863 Alexander Anderson set org. cor. E.T.s Spruce 7 x 26 x 16lks; Aspen 2 x 6 x 21lks.
- May 1906 D.H. Vaughan re-established corner from Konsell information, Konsell established corner by proportionate measure, Vaughan set rocks for cor. position no trees near for E.T.s
May 1916 D.H. Vaughan back at cor.
- 1954 E.A. Vincentsen fd. iron pipe E.T. W. Pine N 70° W 68.15'
- 1967 James Griffin fd. iron pipe E.T. W. Pine E.T.
- 1973 James Marquardt fd. iron pipe E.T. W. Pine E.T. New E.T. 7" double maple S 42° E 29.1'


Description of corner evidence found:

- Found 1 1/2" iron pipe with rocks piled around it and a post along side it
- fd. 2 1/2" W Pine N 58° E 68'
- fd. 7" double maple S 51° E 29'
- checked distance to east 1/4 sec. 18, agreed with Vaughan


Description of monument and accessories I established to perpetuate the location of this corner:

- iron pipe in good condition made the following witnesses:
- 3 1/2" Oak N 56° E 7.32'
- 11" Red Pine S 50° E 42.69'
* measured to P.M. nail in face of blaze
* magnetic bearings
* corner is about 150' south of River Road & 160' west of North Shore Drive

Compared with all record data and accepted as correct.

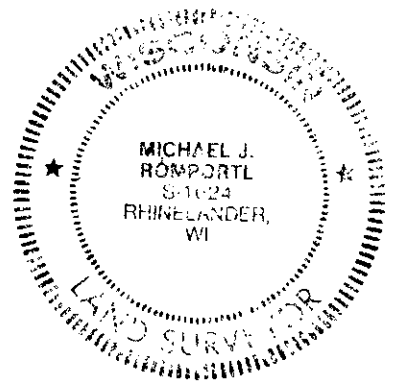

Oneida County Surveyor date

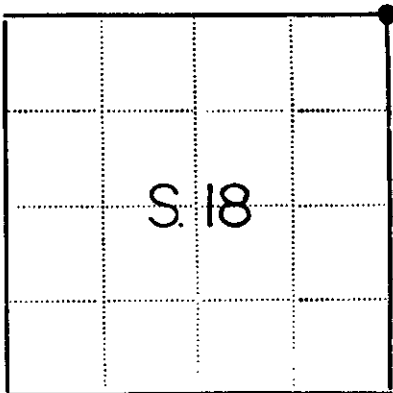

- Corner monument restored
-

Resident witnesses.....

Dated at Rhinelander Wisconsin, this 5th day of November 1981.

Signature Michael J. Romportl Title Reg. Land Surveyor (County Surveyor, Registered Land Surveyor, or other duly authorized official)

Surveyors Registration No. 1624

Office of..... County of.....

I hereby certify that the within instrument was filed in this office for record on the..... day of..... 19....., and was filed in Book No..... Page No..... of County Records.

Signature..... Title.....

Township....., Range....., Section....., Index No....., Page No.....

3808070000