

U.S. PUBLIC LAND SURVEY MONUMENT RECORD

Index No. 13

State of Wisconsin

County of Oneida } ss.

I John H. Fisher, do hereby certify that on the 30 day of October, 1984, I found evidence of the South one quarter corner of Section Township 38, North, Range 8 East, Fourth Principal Meridian, as described hereon; and that from this evidence I established a new monument and accessories as described hereon to perpetuate the original location of this corner.

Resident witnesses:

East

History of original corner establishment:
The original Government survey was performed by Alexander Anderson, Deputy Surveyor in July 1863.
Wood post set:

Yellow Pine 10" 8" S62°W 22 lks
White Pine 8" 8" N67°W 13 lks

Description of corner evidence found:
Nail over 2 inch iron pipe in centerline River Road

Oak 8" N78°W 52.7 feet
Jac. Pipe 6" S55°E 25.7 feet

Description of monument and accessories I established to perpetuate the original location of this corner.
Corner in good condition:
Made the following new ties:

2" iron pipe S88°43'E 33.05 feet
2" iron pipe S22°45'E 72.26 feet
3/4" iron rod N89°24'W 33.05 feet


Set nail in:
Power pole No. 3808-18M12 S60°W 29.32 feet

Dated at Minocqua, Wis., this 27th day of May, 1985.

Signature [Signature] Title Registered Land Surveyor Registration No. S-836
(County Surveyor, Registered Land Surveyor, or other duly authorized official)

Office of Register of Deeds, County of Oneida
Instrument was filed in this office for record on the 11 day of June, 1984, at 4:00 o'clock P. M. I hereby certify that the within

By [Signature] Deputy
[Signature] (Register of Deeds)

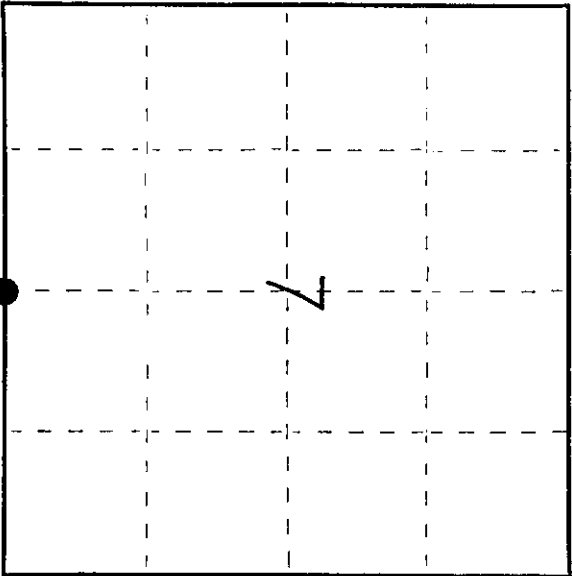

● = Corner monument restored.

3808070020

