

CERTIFIED LAND CORNER RESTORATION

State of Wisconsin }  
County of Oneida } ss.

I Jerome N. Kraemer, do hereby certify that on the 16th day of April, 1981, I found evidence of the Section corner of 8, 9, 16 and 17 Township 38 North, Range 8 East, Fourth Principal Meridian, as described hereon; and that from this evidence I established a new monument and accessories as described hereon to perpetuate the original location of this corner:

Description of original monument and accessories and subsequent restorations:

Original corner, a wood post, established in July, 1863 by Alexander Anderson, Government Deputy Surveyor  
Y. Pine 20 N3°W 4 lks.  
W. Pine 12 N33°E 47 lks.

Map of survey by A. J. Lytle, Surveyor dated October 26, 1946, showing Section 16, T38N, R8E and its subdivision thereof.


Description of corner evidence found:

Found 1" iron pipe extending 8" above ground level. Remains of old scribed post. A W. Pine 17" bears S67°W, 31.2 feet, blaze nearly grown shut, but some scribe marks visible. A N. Pine 21" bears N6°W, 110.0 feet, blaze nearly grown shut but scribe marks visible.

Description of monument and accessories I established to perpetuate the original location of this corner:

April 16, 1981. I blazed and scribed the following new bearing trees and set P.K. nail in lower blaze. Distances measured are to P.K. nail.  
W. Pine 7" S28°E 1.37 feet  
W. Pine 7" S 1°W 14.35 feet  
N. Pine 11" N35°W 37.55 feet.

Corner is approximately 225 feet south of Black Lake Road and approximately 40 feet east of east edge of open swamp.

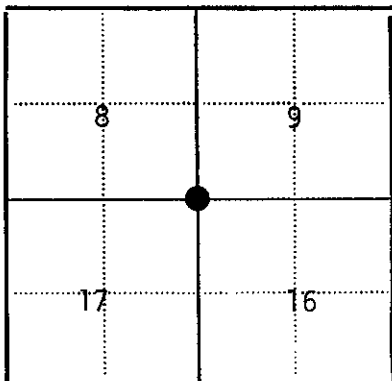

● = Corner monument restored  
□ =

Resident witnesses.....

Dated at Minocqua Wisconsin, this 9th day of March 1982.

Signature Jerome N. Kraemer Title Reg. Land Surveyor  
(County Surveyor, Registered Land Surveyor, or other duly authorized official)

Surveyors Registration No. S-1448

Office of Reg. of Deeds County of Oneida  
I hereby certify that the within instrument was filed in this office for record on the 11 day of June 1982, and was filed in Book No. Page No. of County Records.

Signature Doris Harage Kubo Title Reg. of Deeds  
Cynthia A. Pits, Deputy

Township, Range, Section, Index No., Page No.

3808080000