

G-9

CERTIFIED LAND CORNER RESTORATION

State of Wisconsin }
County of ONEIDA } SS.

I JEROME N. KRAEMER, do hereby certify that on the 13th day of May, 1981, I found evidence of the QUARTER corner of Sections 8 and 9 Township 38 North, Range 8 East, Fourth Principal Meridian, as described hereon; and that from this evidence I established a new monument and accessories as described hereon to perpetuate the original location of this corner:

Description of original monument and accessories and subsequent restorations:

Original corner, a wood post, established in July, 1863 by Alexander Anderson, Government Deputy Surveyor.

W. Pine 10 S42 1/2 W 15 lks
Maple 10 S77 E 86 lks.

Corner restored by person unknown as evidenced in notes on file at Department of Natural Resources Forestry Headquarters, Trout Lake.

Notes refer to two bearing trees:
W. Pine 7 North 108.4 feet
N. Pine 16 N72 E 131 feet

Description of corner evidence found:



I locate two bearing trees, a double W. Pine 13" with lower and upper blazes grown shut and painted blue; the other bearing tree being a N. Pine 21" with lower and upper blazes, Lower blaze is plainly scribed "BT" on lower blaze. I measure south 108.4 feet from W. Pine and S72 W, 131.0 feet and locate remains of old, square, rotted wood post and hole where post once stood. Corner position supported by 1956-57 survey of the NE-SW and Government Lot 3, Section 9, T38N, R8E by Nicholas M. Rowinski, Land Surveyor.

Description of monument and accessories I established to perpetuate the original location of this corner:

June 12, 1981. I set a BERNTSEN A-1 STANDARD MONUMENT being a 2" diameter, 30" long aluminum pipe with a cast clover shaped base and a 3 1/4" diameter cast cap stamped: "ONEIDA COUNTY, T38N, R8E, 1/4, S8, S9, 1981, S-1448, SURVEY MARKER" to identify corner. Both cap and base encompass permanent magnets for detection with an electronic locator. Set 4" diameter, mill cut, beveled top round cedar post painted white with the top 6 inches painted green at pipe.

Established following bearing trees:

Set PK nail in lower blaze of Double White Pine 13" North, 108.4 feet
Set PK nail in lower blaze of Norway Pine 21", N72 E, 131.0 feet
Blazed, scribed and set PK nail in lower blaze of double Maple 8" S84 W, 44.74 feet.

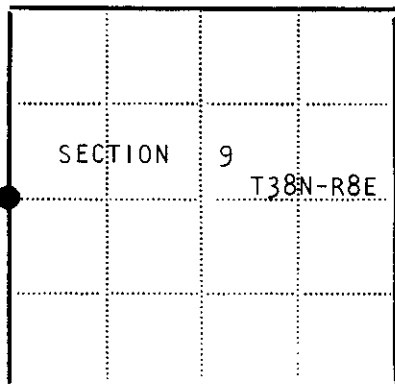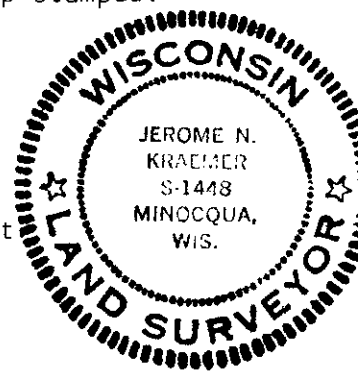

● = Corner monument restored
□ =

Resident witnesses.....

Dated at MINOCQUA Wisconsin, this 8th day of March 19 82.

Signature *Jerome N. Kraemer* Title Registered Land Surveyor (County Surveyor, Registered Land Surveyor, or other duly authorized official)

Surveyors Registration No. S1448

Office of Registrar of Deeds County of Oneida

I hereby certify that the within instrument was filed in this office for record on the 17th day of March 19 82, and was filed in Book No. Page No. of County Records.

Signature *Louise Verge Kuehn* Title Registrar of Deeds

Township, Range, Section, Index No. G-9, Page No.

3808082000