

U.S. PUBLIC LAND SURVEY MONUMENT LOCATION RECORD

Recorders Data

CORNER: West 1/4 SECTION: 17 TOWNSHIP 38 NORTH RANGE 8 EAST/WEST

FOR M.C. CORNER INDICATE: NAME OF WATERWAY N/A SECTION LINE N/A

(CITY)(VILLAGE)(TOWN) OF: Newbold COUNTY OF: Oneida

Description of monument found or placed and all other evidence used as a basis for monument location; including all monuments and related measurements required if the corner location is reestablished by lost corner proportionate methods. Also indicate name of original surveyor, survey date, corner monument set and established bearing trees, witness or reference monuments with ties from available records.


Found and accepted an undisturbed green painted 2" dia. iron pipe monument with uncapped top 12" above grade at this corner location, and an old 4" square wood corner marker post with pointed top 48" high and scribed "1/4" on East face 12" NW of iron pipe monument. I carefully removed the old 2" iron pipe and replaced its location with a standard 2" dia. by 30" long aluminum pipe monument with stamped Oneida County cap flush with existing grade, and I left the removed 48" long iron pipe flat on grade with old wood post nearby. I also placed gravel from nearby roadway shoulder around the base of aluminum monument set to deter grass overgrowth, and set a standard white poly 'T' marker post 10" SE of corner monument.

A typed listing of corner recovery notes, from an unknown source, dated January 15, 1979 as filed in Oneida County survey records, indicates a 2" dia. iron pipe at this corner and BTs, a 12" Pr N65°W 21.8' which I found OK and used for new ties below, and a 16" Pine stump at N68°W 12.5', now very badly decayed and unsuitable for positioning usage. In 1867, Anderson/GLO set a wood post & marked OBTs, 15" Hem S63°W 11 lks & 10" Bw East 19 lks; all now gone. In 1981, Rommorth/Gerick & Associates, noted an iron pipe found at this corner location per Plat of Survey filed as C-961 in Oneida County survey records; he noted no BTs, but set iron pipe monuments for surveyed parcel referenced to the corner iron pipe, which I found and used for ties indicated below. Also see C-102(1967) in Oneida Co. survey records.

No other evidence was observed nor detected within 1/2 chain of corner. This recovery was completed on July 16, 1998; there were no witnesses other than vehicle traffic nearby.

Plan view map of monument location with bearing and distance ties to a minimum of four(4) described witness or reference monuments of concrete, natural stone, iron, live bearing trees or equivalent material. If applicable, also show a minimum of two(2) bearing and distance ties to any other monument found and not accepted; including the bearing and distance from the accepted monument. Indicate the basis for bearings of reference ties if not referenced to magnetic north.

NORTH

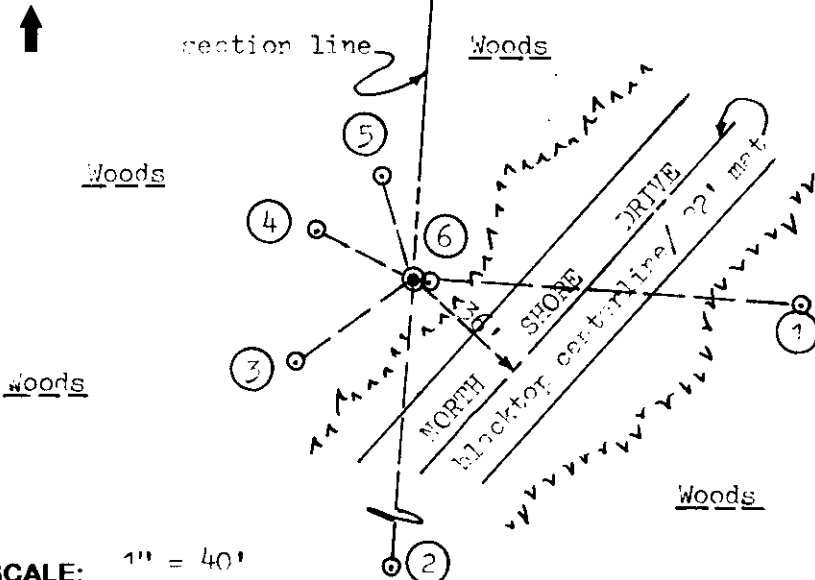

WITNESS MONUMENT TIES:

- ① 1" dia. iron pipe found per Plat of Survey C-961 Oneida Co. survey records S86°E 81.49'.
- ② 1 1/2" dia. iron pipe found per Plat of Survey C-961 Oneida Co. survey records S04°W 115.16'.
- ③ New BT 6" Mr S55°W 30.03'.
- ④ Old BT 16" Pr with upper & lower face blazes open N62°W 22.28'; I nailed a standard BT sign to upper face.
- ⑤ New BT 9" Or N17°W 22.80'.
- ⑥ New BT 4" Pw S80°E 3.26'.

Note: Standard white poly 'T' marker post set 10" SE of corner.


SCALE: 1" = 40'

Unless otherwise indicated, all bearing tree ties are to a .25" dia. by 2.5" long PK nail with a 1.25" dia. steel washer driven into unblazed right face and a .25" dia. by 2.5" long PK nail with a 2" dia. steel washer stamped 'BT' is also driven into unblazed face of bearing tree at DBH; the basis for measured bearings is magnetic to nearest degree and all tie distances are horizontal measure to nearest 1/100th feet.

LAND SURVEYOR CERTIFICATION:

I, William C. Rohde, hereby certify that I am a duly licensed Professional Land Surveyor in Wisconsin, that this USPLS monument location was determined by me or under my direction and control, and that this U.S. Public Land Survey Monument Location Record is true and correct to the best of my knowledge and belief.

William C. Rohde Date: 7-27-98
Signature

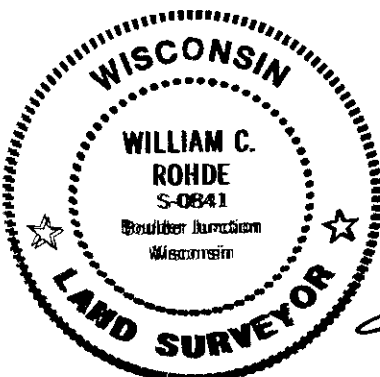

RLS SEAL

SHEET NO. 1 OF 1

This form is intended to fulfill requirements of Chapter A-E 7.08 (3)(a)(b)(c)(d)(e)(f)(g)(h)(i) U.S. Public Land Survey Monument Location Record, Wisconsin Administrative Code. Use reverse side for geodetic location data and/or continuation purposes.

		17	

SECTION LOCATION MAP

INDEX NO. L 5
3808182000

INDEX NO. L 5