U.S. PUBLIC LAND SURVEY MONUMENT RECORD

Note: This form is intended and designed to fulfill all requirements of Wisconsin Administrative Code, Chapter A-E 7.08 U.S. Public Land Survey Monument Record (3) (a) (b) (c) (d) (e) (f) (g) (h) (i). An additional sheet may be added if necessary to conform with said requirements.

(a) Corner location: Township 38 North

Range 8 East/~~West~~

~~Town/City/Village~~ Newbold

County Oneida

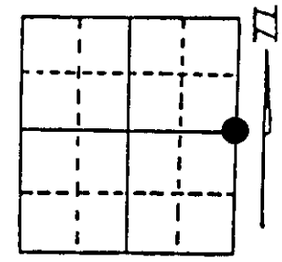

Section 20

(b) (f) (g) (h) Description of monument found at this corner and if it was accepted, state all evidence (material, testimonial, occupational, plats, records, other monuments) used as a basis for accepting. If not accepted or if nothing was found, state evidence used as basis for establishing location. If reestablished through lost corner proportionate methods, indicate all monuments, distances and directions used to establish. Indicate type of monument found or set and sign post.

1863 - Alexander Anderson established this corner and set a wood post and made two BTs:
6" Fir, S38°W, 4 Links
8" Hemlock, N75°E, 12 Links

4/18/1910 - Vaughan used corner and made new BT, 34" Pine Stump, S50°E, 120 Links.

1963 - Poskie used corner to lay out lots in NW1/4SW1/4 to Section 21.

6/15/1991 - Found iron pipe 4" below road surface with Witness Corner pipes East 33.0' and West 29.8'. Also, a scribed Pine Stump, S75°E, 41.0'.
We left iron pipe in road to mark the Quarter Corner, set an aluminum monument Easterly 33.0' marked "Witness Corner"; made new BTs and set plastic sign post.

(c) (d) (e) Plan view of corner with ties to at least 4 witness monuments. If in disagreement with previously established corner, show the distances between the two corners and also indicate the ties to the disputed corner.

1) Iron Pipe, 4" below road surface.
2) 2" x 30" aluminum monument as W.C. Easterly, 33.0' (Replaced 1" iron pipe).
3) 2" x 10" high, iron pipe, Westerly, 29.8'.
4) 12" White Pine, N72°E, 57.56'.
5) 12" Red Pine, S43°E, 58.43'.
6) 12" Red Pine, S52°W, 36.51'.
7) 14" Red Pine, N30°W, 44.35'.
8) Plastic sign post, West, 29.1'.

Distances to nail in side of BTs.
BT stumps blazed and scribed "BT".

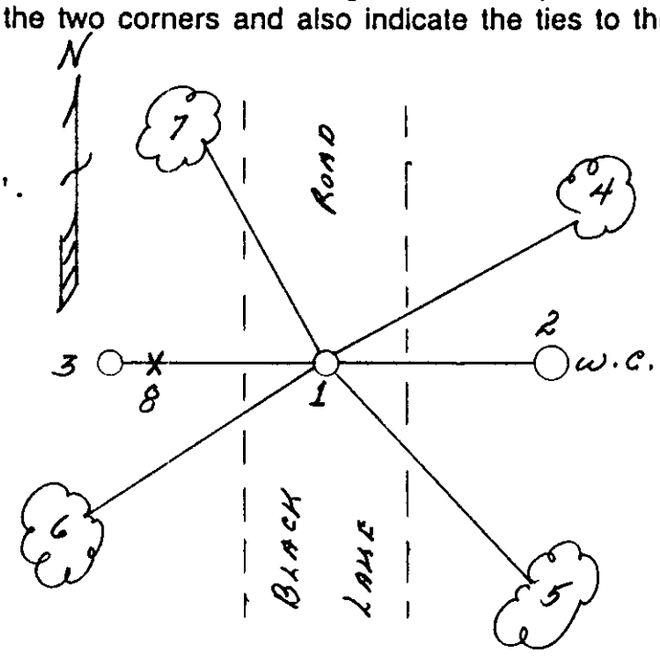

(i) I, Milo E. Stefan (type or print name) certify that the corner location on this record was determined by me or under my direction and control and that this U.S. Public Land Survey Monument Record is correct and complete to the best of my knowledge and belief.

Milo E. Stefan
Signature

October 14, 1991
Date

WISCONSIN
MILO E. STEFAN
S-1558
RHINELANDER, WIS.
LAND SURVEYOR

Index No. P-9

Stamp 38082020000