


U.S. PUBLIC LAND SURVEY MONUMENT RECORD

Note: This form is intended and designed to fulfill all requirements of Wisconsin Administrative Code, Chapter A-E 7.08 U.S. Public Land Survey Monument Record (3) (a) (b) (c) (d) (e) (f) (g) (h) (i). An additional sheet may be added if necessary to conform with said requirements.

(a) Corner location: Township 38 North
 Range 8 East West

Town/City/Village Newbold

County Oneida

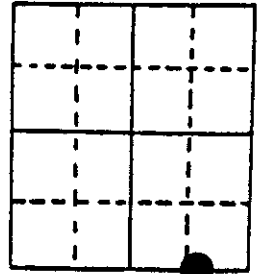

Section 21

(b) (f) (g) (h) Description of monument found at this corner and if it was accepted, state all evidence (material, testimonial, occupational, plats, records, other monuments) used as a basis for accepting. If not accepted or if nothing was found, state evidence used as basis for establishing location. If reestablished through lost corner proportionate methods, indicate all monuments, distances and directions used to establish. Indicate type of monument found or set and sign post.

1863 - Alexander Anderson established this corner and set a wood post with BTs:
 8" W. Pine, S84°E, 25 Links 10" W. Pine, N64°E, 33 Links


1974 - Herb Moore called a 1 1/2" x 12" iron pipe on the certified survey map on southeast shore of Tom Doyle Lake as the Meander Corner.

5/18/1989 - Milo E. Stefan found the above pipe and accepted it as the perpetuated Meander Corner location. We replaced the iron pipe with an aluminum county monument, made new BTs and placed a plastic sign post.

(c) (d) (e) Plan view of corner with ties to at least 4 witness monuments. If in disagreement with previously established corner, show the distances between the two corners and also indicate the ties to the disputed corner.

- 1) 2 1/2" x 30" aluminum county monument
- 2) 12" Red Maple, N70°E, 29.33'
- 3) 10" Red Pine, S13°E, 75.55'
- 4) 14" White Pine, N21°E, 10.45'
- 5) 1 1/2" x 12" high iron pipe, NW corner of lot #1 to Moore's CSM
- 6) Plastic sign post, N25°E, 11.4'

Distances to Nail in side of BTs.
 BTs scribed "BT" in stump blaze.

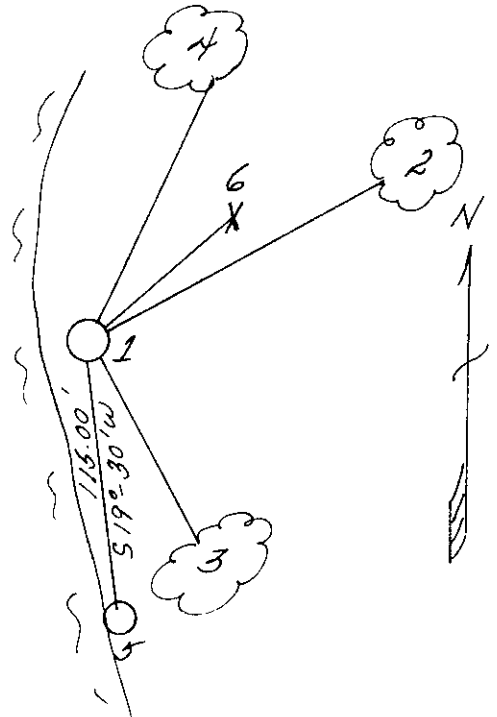

(i) I, Milo E. Stefan
 (type or print name) certify that the corner location on this record was determined by me or under my direction and control and that this U.S. Public Land Survey Monument Record is correct and complete to the best of my knowledge and belief.

Milo E. Stefan
 Signature

8/10/89
 Date



3808 2100 09

Index No. R-12, 13