

U.S. PUBLIC LAND SURVEY MONUMENT RECORD

Note: This form is intended and designed to fulfill all requirements of Wisconsin Administrative Code, Chapter A-E 7.08 U.S. Public Land Survey Monument Record (3) (a) (b) (c) (d) (e) (f) (g) (h) (i). An additional sheet may be added if necessary to conform with said requirements.


(a) Corner location: Township 38 North Corner: West 1/4 Corner

Section 19 Range 9 East Original Surveyor: Hiram C. Fellows

Town/City/Village Sugar Camp

Original B.T.'s: 6" Tam N26°W 13 lks
6" Tam N23°E 11 lks

County Oneida

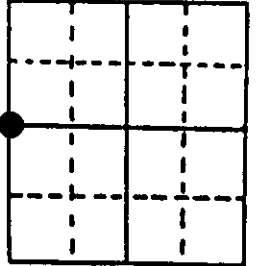


Original Survey Date: May 1859 ● Location

(b) (f) (g) (h) Description of monument found at this corner and if it was accepted, state all evidence (material, testimonial, occupational, plats, records, other monuments) used as a basis for accepting. If not accepted or if nothing was found, state evidence used as basis for establishing location. If reestablished through lost corner proportionate methods, indicate all monuments, distances and directions used to establish. Indicate type of monument found or set and sign post.

Found and accepted a standard 2" dia. iron pipe monument with stamped WCD brass cap tipped about 10° North at corner location; I lowered and plumbed monument for new ties with cap 16" above grade. Also found a 1" dia. by 44" long iron pipe tipped 45° about 4" SE of corner monument, which I pulled and left flat on grade next to brass capped monument found. I also set a standard white poly 'T' corner marker post 1' East of corner monument found. I filled cavity around the corner monument in bog/marsh with crushed granite from adjacent roadway to stabilize monument and to aid future recovery. All original GLO survey corner evidence is now obliterated or of unreliable condition. In 1956, Kowalke found the original GLO corner location and set the WCD brass capped monument; he also noted a new BT 5" Tam N35°W at 0.050 chains, which I found as a 10" Tam with upper and lower face blazes shut but scars plain, and used for new ties below.

This recovery completed September 23, 1997 and was witnessed by caretaker of adjacent T.A. Solberg, Inc. property, who pointed out the corner monument to me the previous day.

(c) (d) (e) Plan view of corner with ties to at least 4 witness monuments. If in disagreement with previously established corner, show the distances between the two corners and also indicate the ties to the disputed corner.

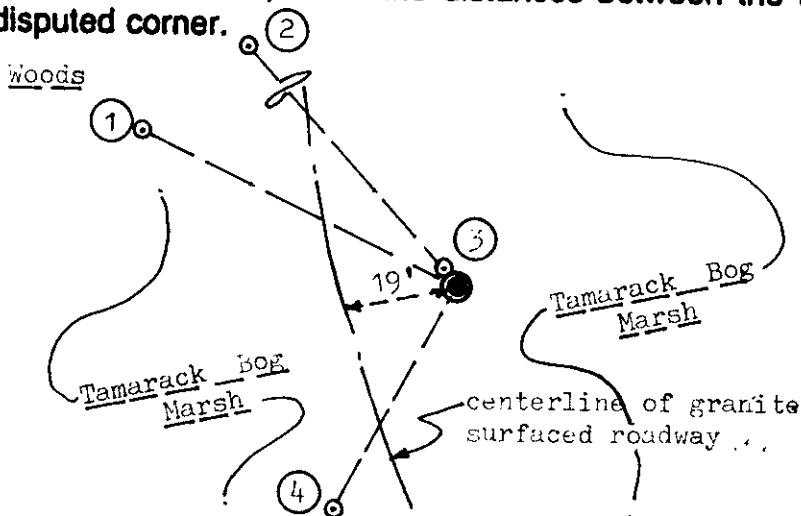


Witness Monument Ties:

- ① New BT 4" Mr, SE Trunk of two, N63°W 55.34'.
- ② New BT 11" Mr, SE Trunk of two, N41°W 102.89'.
- ③ Record BT 10" Tam with upper and lower face blazes shut but plain, N35°W 3.29'.
- ④ New BT 6" Tam S29°W 62.62'.

Unless otherwise indicated, all BT witness monument ties are to a 1/4" dia. by 2.5" long PK nail with 1.25" dia. steel washer set in unblazed right face bark; and a PK nail with 2" dia. steel washer stamped BT also set in unblazed front face bark of each BT at DBH. All previous corner recovery notes from Wisconsin DNR and/or Oneida County survey records.

Scale: 1" = 30'

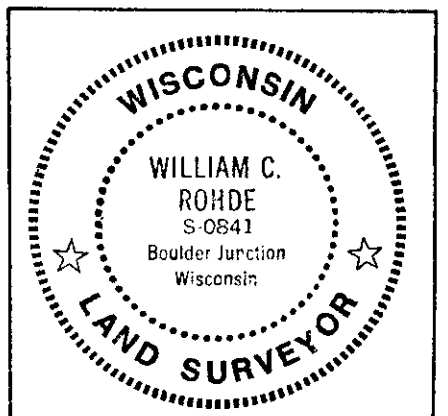

(i) I, William C. Rohde, RLS 841
(type or print name) certify that the corner location on this record was determined by me or under my direction and control and that this U.S. Public Land Survey Monument Record is correct and complete to the best of my knowledge and belief.

William C. Rohde
Signature

9-29-97
Date