U.S. PUBLIC LAND SURVEY MONUMENT RECORD

Note: This form is intended and designed to fulfill all requirements of Wisconsin Administrative Code, Chapter A-E 7.08 U.S Public Land Survey Monument Record (3) (a) (b) (c) (d) (e) (f) (g) (h) (i). An additional sheet may be added if necessary to conform with said requirements.

(a) Corner location: Township 38 North

Range 8 East/~~West~~

Town/City/~~Village~~ Oneida

County _____

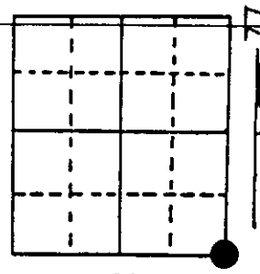

Section 26

(b) (f) (g) (h) Description of monument found at this corner and if it was accepted, state all evidence (material, testimonial, occupational, plats, records, other monuments) used as a basis for accepting. If not accepted or if nothing was found, state evidence used as basis for establishing location. If reestablished through lost corner proportionate methods, indicate all monuments, distances and directions used to establish. Indicate type of monument found or set and sign post.

July 1863 - Alexander Anderson established this corner and set a wood post with two BTs:
8" Birch, N4°W, 24 Links 7" Birch, N35°E, 22 Links

1970's - Kirby, from Genisot Engineering, restored this corner in the preparation of the subdivision plat of "Timber Ranch Estates". He subdivided Section 26 and cut out the SE¼SE¼ of this section.

3/29/1991 - Milo E. Stefan found corner marked with a 2" x 2" x 4' scribed cedar stake, a 1/2" x 24" iron pipe below ground and two BTs:
16" White Pine, S29°E, 13.43' 12" White Birch, N87°W, 16.56'
Corner falls on south edge of road in 2' of fill. We placed a county monument and two new BTs.

(c) (d) (e) Plan view of corner with ties to at least 4 witness monuments. If in disagreement with previously established corner, show the distances between the two corners and also indicate the ties to the disputed corner.

1) 2" x 36" aluminum county monument in mound of stone
2) 14" White Pine, N48°E, 57.56'
*3) 16" White Pine, S29°E, 16.56'
4) 12" Red Pine, S13°W, 37.33'
*5) 12" White Birch, N87°W, 13.43'
6) Plastic sign post, Southwest, 1.85'

Distances to nail in side of BTs.
Stump blazes scribed "BT".

*Trees overgrown, not rescribed.

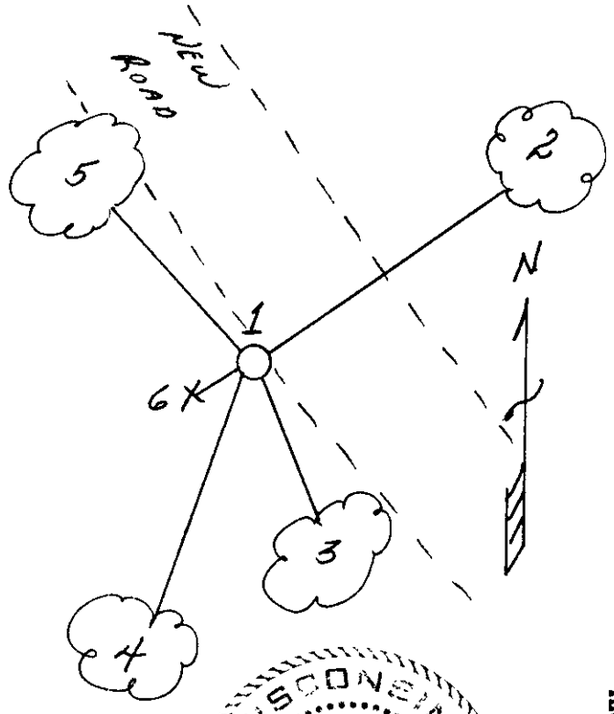

REGISTER OF DEEDS OFFICE
ONEIDA COUNTY, WIS.
FILED
APR 8 1991
At _____ O'Clock _____ M
THOMAS H. LEIGHTON
REGISTER OF DEEDS

(i) I, Milo E. Stefan (type or print name) certify that the corner location on this record was determined by me or under my direction and control and that this U.S. Public Land Survey Monument Record is correct and complete to the best of my knowledge and belief.

Milo E. Stefan March 30, 1991

Signature Date

WISCONSIN MILO E STEFAN S-1553 LAND SURVEYOR

Stamp

Index No. V-21