# U.S. PUBLIC LAND SURVEY MONUMENT RECORD

Note: This form is intended and designed to fulfill all requirements of Wisconsin Administrative Code, Chapter A-E 7.08 U.S. Public Land Survey Monument Record (3) (a) (b) (c) (d) (e) (f) (g) (h) (i). An additional sheet may be added if necessary to conform with said requirements.

(a) Corner location: Township 38 North

Range 8 East/West

Town/City/Village Newbold

County Oneida

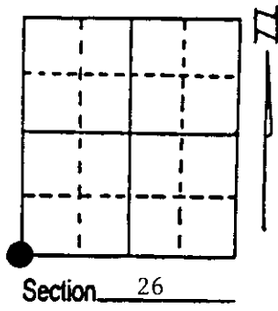

Section 26

(b) (f) (g) (h) Description of monument found at this corner and if it was accepted, state all evidence (material, testimonial, occupational, plats, records, other monuments) used as a basis for accepting. If not accepted or if nothing was found, state evidence used as basis for establishing location. If reestablished through lost corner proportionate methods, indicate all monuments, distances and directions used to establish. Indicate type of monument found or set and sign post.

1863 - Alexander Anderson established this corner and set a wood post with four BTs:
5" Spruce, N25°E, 15 Links
6" Tamarack, S33°E, 21 Links
5" Spruce, S66°W, 36 Links
5" Spruce, N61°W, 19 Links

3/12/1912 - Vaughan could not locate this corner. He, therefore, restored it by Lost Methods. He set a wood post and two new BTs:
9" Tamarack, S1/2°W, 27 Links
5" Spruce, N12½°E, 14½ Links

3/28/1991 - Milo E. Stefan found both of Vaughan's BTs with point of post rotted off. Spruce BT is badly decayed stump and Tamarack a 3' high snag, scribing plain. I set a new aluminum monument, made four new BTs and set plastic sign post.

(c) (d) (e) Plan view of corner with ties to at least 4 witness monuments. If in disagreement with previously established corner, show the distances between the two corners and also indicate the ties to the disputed corner.

1) 1" x 72" aluminum monument
2) 6" Black Spruce, N27°E, 22.96'
3) 6" Black Spruce, S82°E, 18.52'
4) 12" White Pine, S45°W, 11.65'
5) 12" White Pine, North, 53.28'
6) Plastic Sign Post, Northwest, .2'

Distances to nail in side of BTs.
Stump blazes scribed "BT".

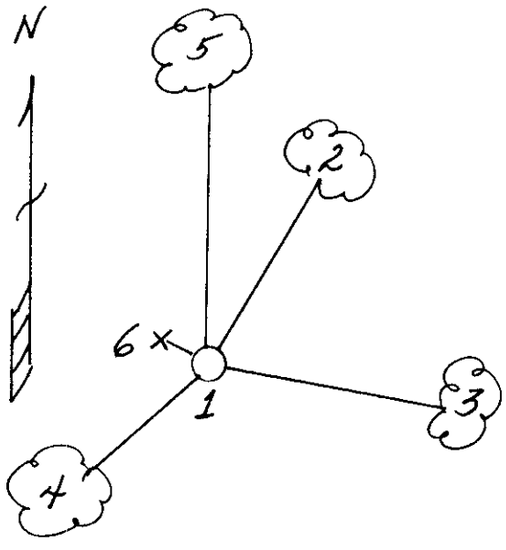


REGISTER OF DEEDS OFFICE
ONEIDA COUNTY, WIS.
FILED
APR 8 1991
At _____ O'Clock _____ M
THOMAS H. LEIGHTON
REGISTER OF DEEDS

(i) I, Milo E. Stefan
(type or print name) certify that the corner location on this record was determined by me or under my direction and control and that this U.S. Public Land Survey Monument Record is correct and complete to the best of my knowledge and belief.

Milo E. Stefan — April 3, 1991

Signature — Date

WISCONSIN
MILO E. STEFAN
S-1558
RHINELANDER, WIS.
LAND SURVEYOR

Index No. V-17

3808270000

Stamp