U.S. PUBLIC LAND SURVEY MONUMENT RECORD

Note: This form is intended and designed to fulfill all requirements of Wisconsin Administrative Code, Chapter A-E 5.02, U.S. Public Land Survey Monument Record (3) (a) (b) (c) (d) (e) (f) (g) (h) (i). An additional sheet may be added if necessary to conform with said requirements.

(a) Corner location: Township 38 North

Range 8 East ~~West~~

Town/~~City/Village~~: NEWBOLD

County ONEIDA

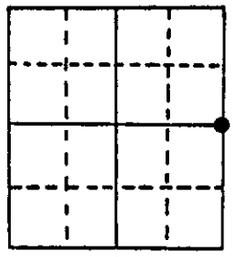

Section 31

(b) (f) (g) (h) Description of monument found at this corner and if it was accepted, state all evidence (material, testimonial, occupational, plats, records, other monuments) used as a basis for accepting. If not accepted or if nothing was found, state evidence used as basis for establishing location. If reestablished through lost corner proportionate methods, indicate all monuments, distances and directions used to establish.

Corner set by Robert Bandow in 1956. He made 2 BT's Ash 10" S40W 47.2' & Maple 10" N88-30W 38.1'. I found his Ash BT & set a 5' aluminum monument from it. At corner position we found several points of wood stakes. Corner is set flush to prevent removal by ice chunks.

(c) (d) (e) Plan view of corner with ties to at least 4 witness monuments. If in disagreement with previously established corner, show the distances between the two corners and also indicate the ties to the disputed corner.

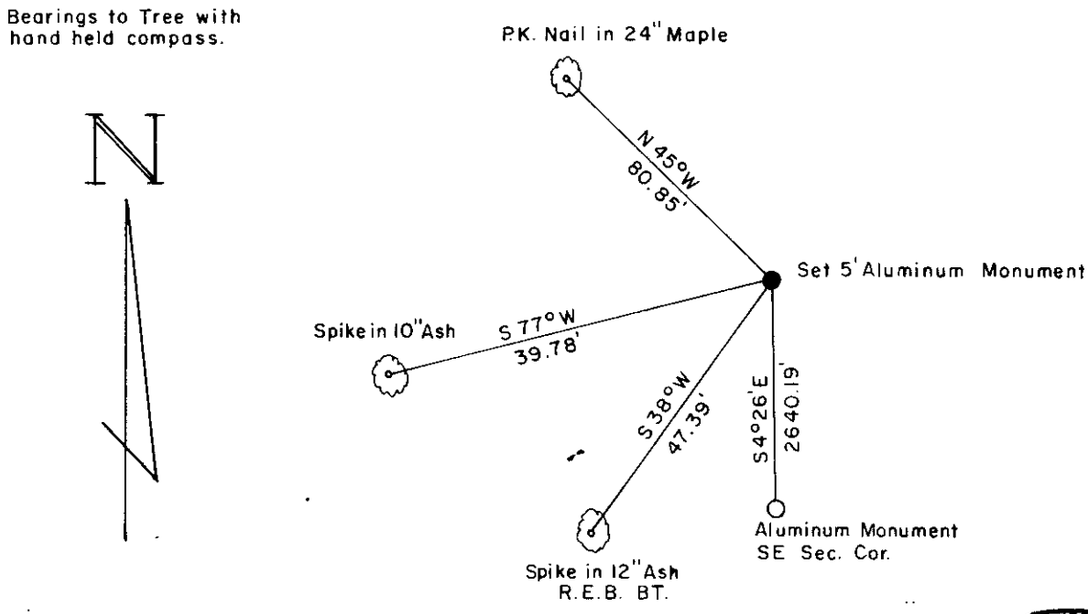

(i) I, William E. Bandow
(type or print name) certify that the corner location on this record was determined by me or under my direction and control and that this U.S. Public Land Survey Monument Record is correct and complete to the best of my knowledge and belief.

William E Bandow 12-7-84

Signature Date

WISCONSIN
WILLIAM E. BANDOW
S 1182
RHINELANDER
WIS.
LAND SURVEYOR

Index No. X-5

3804831200