

U.S. PUBLIC LAND SURVEY MONUMENT RECORD


Note: This form is intended and designed to fulfill all requirements of Wisconsin Administrative Code, Chapter A-E 5.02, U.S. Public Land Survey Monument Record (3) (a) (b) (c) (d) (e) (f) (g) (h) (i). An additional sheet may be added if necessary to conform with said requirements.

(a) Corner location: Township 37 North

Range 8 East/West

Town/City/Village Pine Lake

County Oneida

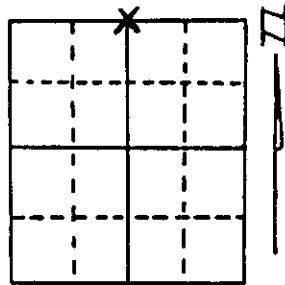

Section 2

(b) (f) (g) (h) Description of monument found at this corner and if it was accepted, state all evidence (material, testimonial, occupational, plats, records, other monuments) used as a basis for accepting. If not accepted or if nothing was found, state evidence used as basis for establishing location. If reestablished through lost corner proportionate methods, indicate all monuments, distances and directions used to establish.

September 1860, Alfred Millard at 40.00 chains set post for 1/4 corner to sections 2 and 35 and two BTs:

6" Spruce, N52°E, 16 Links (10.56')

6" Red Pine, S5 1/2°E, 33 Links (21.78')

March 28, 1977 N. Loftus called old BTs only. From county survey map #C347.

February 8, 1988 Milo Stefan found "RIPCO" monument, a 3" x 3" x 1/4" brass plate atop 1 1/4" iron pipe 18" high with two BTs:


14" Red Pine, N26°E, 40.37'

12" Red Pine, S20°E, 30.96'

(c) (d) (e) Plan view of corner with ties to at least 4 witness monuments. If in disagreement with previously established corner, show the distances between the two corners and also indicate the ties to the disputed corner.

1. "RIPCO" monument, brass plate on 1 1/4" iron pipe.
2. 14" Red Pine, N26°E, 40.37'
3. 12" Red Pine, S20°E, 30.96'
4. 8" Black Spruce, S22°W, 27.03' (Scribed 1/4S BT)
5. 4' x 3' x 2' gray granite boulder with "X" chiseled on high point. N51°W, 13.32'
6. Plastic sign post, North, 1.6'

Measurements to nail in side of trees.

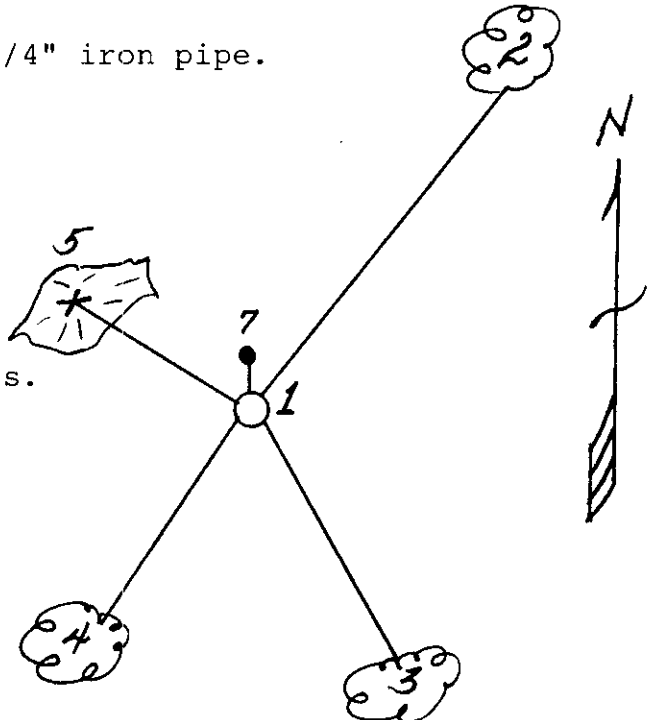

(i) I, Milo E. Stefan
 (type or print name) certify that the corner location on this record was determined by me or under my direction and control and that this U.S. Public Land Survey Monument Record is correct and complete to the best of my knowledge and belief.

Milo E. Stefan 2/24/88
 Signature Date



Index No. A-19

3808 350020