

CERTIFIED LAND CORNER RESTORATION

Index No. A-24

State of Wisconsin

County of Oneida } ss.



I Phillip T. Hansen do hereby certify that on the 22nd day of April, 1977, I found evidence of the E 1/16 corner of the Section 36 - 1 Township 37-38, North, Range 8 East, Fourth Principal Meridian,

as described hereon; and that from this evidence I established a new monument and accessories as described hereon to perpetuate the original location of this corner.

Resident witnesses:

Jm Claffin

Herb Wagoner

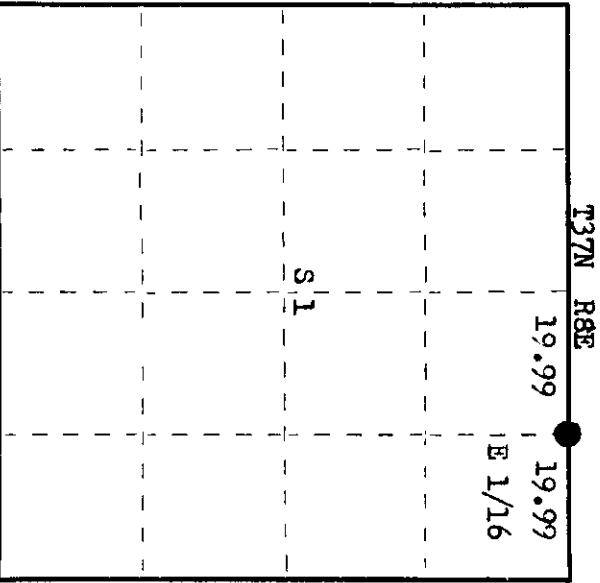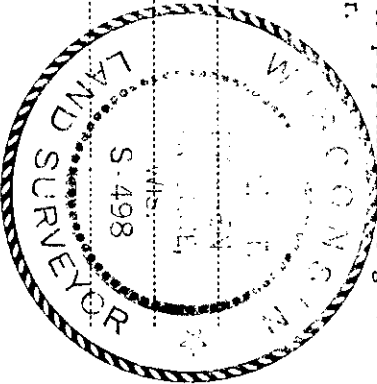

○ = Corner monument restored.

History of original corner establishment:

Corner established by N. Loftus, Ripco Surveyor, in 1960. From recovered and restored NW section corner ran random line bearing 269° 41' mag. 79.96 chains to close out 1.60 chains north of NW corner. Set W 1/16 corner at 19.99 chains east on corrected bearing S88° 31' W, equidistant to NE corner.

Marked NEts - Red Pine 5" S22°E, 29½ links and Tamarack 3" N42°E, 14½ links.

Description of corner evidence found:

Recovered 1" iron pipe with 2" brass cap in excellent condition, cap stamped:

Monument projects 24" above ground.

Recovered OBts - Red Pine 5" (6") S22°E, 29.5 links (29.1 links),

scribed E 1/16 S1 BT.

Tamarack 3" N42°E, 14.25 links, scribed E 1/16 S36 BT.

T38N R8E
S136
E 1/16 S31
T37N R8E
RIPCO

Description of monument and accessories I established to perpetuate the original location of this corner.

Marked NEt - Black Spruce 7" S59°W, 27.5 links, scribed 1/16 BT.

Dated at Rhineland, Wis. this 4th day of May, 1977.

Signature Phillip T. Hansen Title Registered Land Surveyor Registration No. S-498
(County Surveyor, Registered Land Surveyor, or other duly authorized official)

Office of Register of Deeds, County of Oneida. I hereby certify that the within instrument was filed in this office for record on the 6th day of May, 1977 at 10 o'clock P. M.

Louise Wenger Kuehn
(Register of Deeds)

By: _____ Deputy

3808.360010