

CERTIFIED LAND CORNER RESTORATION

Index No. A-22



State of Wisconsin }
County of Oneida } ss.

I Phillip T. Hansen, do hereby certify that on the 20th day of April, 19 77, I found evidence of the W 1/16 corner of Section 1 & 36 Township 37-38, North, Range 8 East, Fourth Principal Meridian, as described hereon; and that from this evidence I established a new monument and accessories as described hereon to perpetuate the original location of this corner.

Resident witnesses:

Jim Clafin

Herb Wagoner

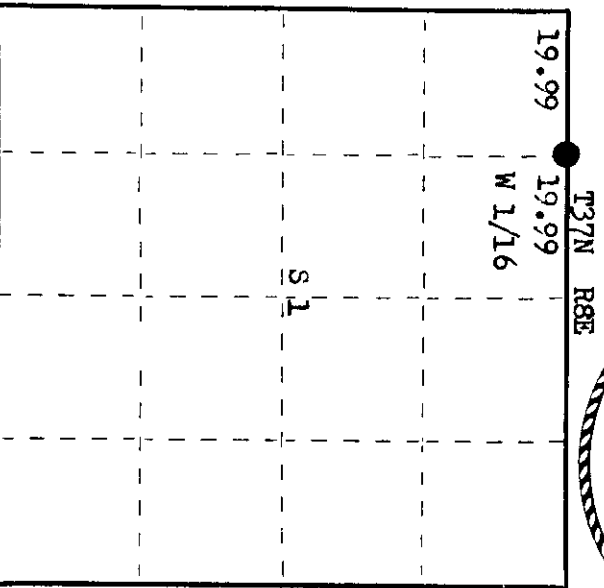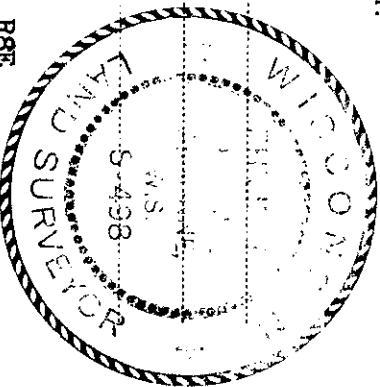

○ = Corner monument restored.

History of original corner establishment:

Corner established by N. Loftus, Ripco Surveyor, in 1960. Ran random line from recovered and restored NE Section Corner, bearing 269° 41' mag. a distance of 79.96 chains to close out 1.60 chains north of NW Section Corner. Set 1/4 corner at 39.98 chains equidistant on true line and set W 1/16 corner at 19.99 chains west of 1/4 corner intermediate.

Marked NBTs - Red Pine 5" S89°E, 26-3/4 links
Red Pine 7" N4°W, 31 1/2 links

Description of corner evidence found:

Recovered 1" iron pipe with 2" square brass cap, stamped:
Monument recovered in excellent condition and firmly in ground.
Monument projects 2 1/4" above ground. T38N R8E
Recovered OBTs - Red Pine 5" (7") S89°E (S55°E) 26.75 links, W 1/16 S136
scribed W 1/16 S1 BT. T38N R8E
Red Pine 7" (10") N4°W, 31.5 links, R1P00
scribing not legible.

Description of monument and accessories I established to perpetuate the original location of this corner. As the monument was recovered in excellent condition, it was left as found. No additional accessories recovered.

Dated at Rhineland, Wis., this 4th day of May, 19 77

Signature Phillip T. Hansen Title Registered Land Surveyor Registration No. S-498
(County Surveyor, Registered Land Surveyor, or other duly authorized official)

Office of Register of Deeds, County of Oneida
Instrument was filed in this office for record on the 6th day of May, 19 77
at 1st o'clock P. M.

Debra Leverage Register
(Register of Deeds)

By: _____ Deputy

3808.360030