U.S. PUBLIC LAND SURVEY MONUMENT RECORD

Note: This form is intended and designed to fulfill all requirements of Wisconsin Administrative Code, Chapter A-E 5.02, U.S. Public Land Survey Monument Record (3) (a) (b) (c) (d) (e) (f) (g) (h) (i). An additional sheet may be added if necessary to conform with said requirements.

(a) Corner location: Township 38 North

Range 9 East/~~West~~

Town/~~City/Village~~ Sugar Camp

County Oneida

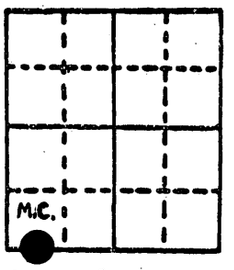

Section 1

(b) (f) (g) (h) Description of monument found at this corner and if it was accepted, state all evidence (material, testimonial, occupational, plats, records, other monuments) used as a basis for accepting. If not accepted or if nothing was found, state evidence used as basis for establishing location. If reestablished through lost corner proportionate methods, indicate all monuments, distances and directions used to establish.

-1863 W. Dougherty 78.80 over lake set M.C. W. Pine 36" S 87 W 24 lks.
W. Pine 20" N 21 W 45 lks.

-1956 G.L.O. set concrete monument with brass cap Maple 9" S 6½ W 30 lks.
Birch 6" N 68 W 15 lks.
NE corner Tavern S 42 1/4 W 28 lks.

-1991 W.E. Bandow found brass capped monument and witnessed as shown below:

(c) (d) (e) Plan view of corner with ties to at least 4 witness monuments. If in disagreement with previously established corner, show the distances between the two corners and also indicate the ties to the disputed corner.

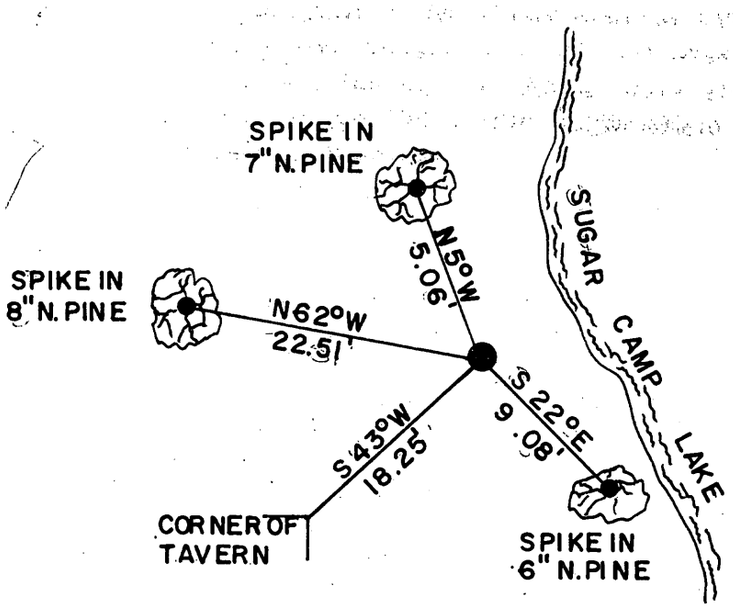

— Magnetic Bearings Taken With Handheld Compass
— Distance to 6" Nail in Side of tree
— No Scale

N

REGISTER OF DEEDS OFFICE
ONEIDA COUNTY, WIS.
FILED
DEC 12 1991
At _____ O'Clock _____ M
THOMAS H. LEIGHTON
REGISTER OF DEEDS

(i) I, William E. Bandow
(type or print name) certify that the corner location on this record was determined by me or under my direction and control and that this U.S. Public Land Survey Monument Record is correct and complete to the best of my knowledge and belief.

William E. Bandow 12-10-91

Signature Date

GENISOT & ASSOCIATES INC.
1512 EAGLE ST., RHINELANDER, WIS.

WISCONSIN
WILLIAM E. BANDOW
S-1182
RHINELANDER
WIS.
LAND SURVEYOR

Index No. E-21,22

38090100 89