

U.S. PUBLIC LAND SURVEY MONUMENT LOCATION RECORD

Recorders Data

CORNER: North 1/4 SECTION: 16 TOWNSHIP 38 NORTH RANGE 9 EASTWEST

FOR M.C. CORNER INDICATE: NAME OF WATERWAY N/A SECTION LINE N/A

(CITY)(VILLAGE)(TOWN) OF: Sugar Camp COUNTY OF: Oneida

Description of monument found or placed and all other evidence used as a basis for monument location; including all monuments and related measurements required if the corner location is reestablished by lost corner proportionate methods. Also indicate name of original surveyor, survey date, corner monument set and established bearing trees, witness or reference monuments with ties from available records.


Found a disturbed standard 2" dia. by 30" long aluminum pipe monument with stamped Oneida County cap tipped about 30° South at corner location. Using record ties by T. Loftus from his file and described herein, I carefully reset the found monument at the previous corner position with cap 5" above existing bog/marsh surface; I also placed several large rocks around the base of the monument to secure. I also found a tipped standard white poly 'T' marker post which I reset 18" North of the corner monument. In 1863, Daugherty/GLO set a wood post as the corner and marked OBTs, a 12" Cedar N72°E 26 lks and an 8" Fir S18°W 11 lks, which are all now obliterated. In 1909, Vaughn noted he could not find any evidence of GLO corner, so he set a new corner midway on a right line between opposite section corners and marked new BTs, a 12" Bw N27½°E 54 lks and a 12" Cedar S63½°E 71 lks; post by Vaughn and both BTs are now obliterated. In 1991, T. Loftus also reset the corner midway on a right line between opposite section corners, with standard aluminum monument described above, and marked new BTs, which I found and used for new ties described below.

Reference: Plat of Survey by T. Loftus, filed as L-1181, Oneida County survey records.

This recovery completed May 26, 1998; there were no witnesses.

I used ties distances by Loftus from Witness BTs #1, #4 and #6 to reset corner monument, as his tie distance to Witness BT #2 check measured 0.20' shorter.

Plan view map of monument location with bearing and distance ties to a minimum of four(4) described witness or reference monuments of concrete, natural stone, iron, live bearing trees or equivalent material. If applicable, also show a minimum of two(2) bearing and distance ties to any other monument found and not accepted; including the bearing and distance from the accepted monument. Indicate the basis for bearings of reference ties if not referenced to magnetic north.

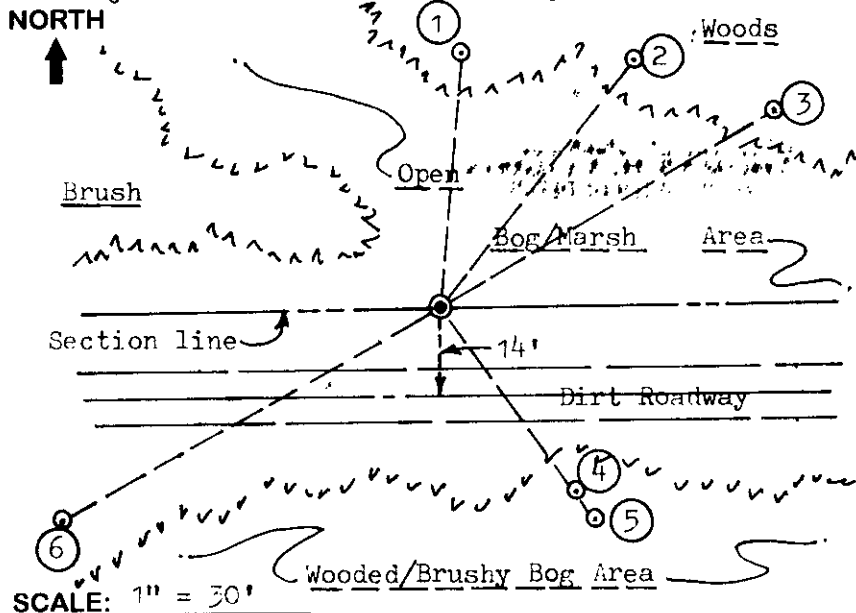


WITNESS MONUMENT TIES:

- ① Loftus BT found, 6" Black Ash with 60d spike in left face of West trunk of two, N05°E 40.22'.
- ② Loftus BT found, 13" Tamarack with 60d spike in right face of SE trunk of two, N38°E 49.50'.
- ③ New BT 12" Tamarack N60°E 61.03'.
- ④ Loftus BT found, 9" Bw with 60d spike in right face, S36°E 35.37'.
- ⑤ New BT 9" Bw S36°E 40.43'.
- ⑥ Loftus BT found, 9" Mr with 60d spike in right face, at S61°W, not at S44°W, 67.91'.

Note: All Loftus BTs found with upper and lower face blazes open and plain.

Unless otherwise indicated, all bearing tree ties are to a .25" dia. by 2.5" long PK nail with a 1.25" dia. steel washer driven into unblazed right face and a .25" dia. by 2.5" long PK nail with a 2" dia. steel washer stamped 'BT' is also driven into unblazed face of bearing tree at DBH; the basis for measured bearings is magnetic to nearest degree and all tie distances are horizontal measure to nearest 1/100th feet.

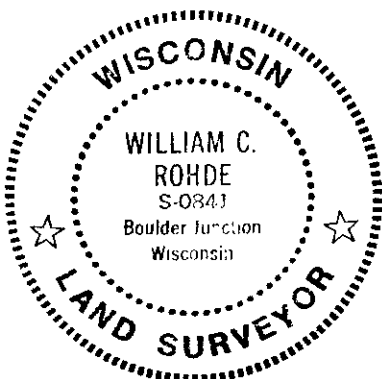

RLS SEAL


SHEET NO. 1 OF 1

LAND SURVEYOR CERTIFICATION:

I, William C. Rohde, hereby certify that I am a duly licensed Professional Land Surveyor in Wisconsin, that this USPLS monument location was determined by me or under my direction and control, and that this U.S. Public Land Survey Monument Location Record is true and correct to the best of my knowledge and belief.

William C. Rohde Date: 5-28-98
Signature

This form is intended to fulfill requirements of Chapter A-E 7.08 (3)(a)(b)(c)(d)(e)(f)(g)(h)(i) U.S. Public Land Survey Monument Location Record, Wisconsin Administrative Code. Use reverse side for geodetic location data and/or continuation purposes.

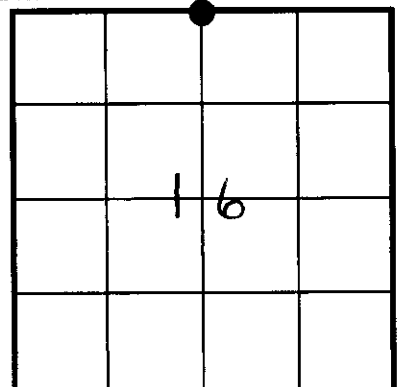

SECTION LOCATION MAP

INDEX NO. 3809090020

INDEX NO. 5-11