U.S. PUBLIC LAND SURVEY MONUMENT RECORD

Note: This form is intended and designed to fulfill all requirements of Wisconsin Administrative Code, Chapter A-E 7.08 U.S Public Land Survey Monument Record (3) (a) (b) (c) (d) (e) (f) (g) (h) (i). An additional sheet may be added if necessary to conform with said requirements.

(a) Corner location: Township 38 North

Range 9 East/West

Town/City/Village Sugar Camp

County Oneida

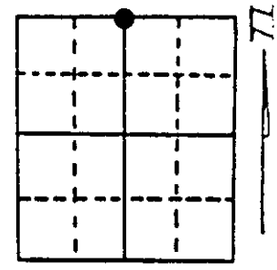

Section 21

(b) (f) (g) (h) Description of monument found at this corner and if it was accepted, state all evidence (material, testimonial, occupational, plats, records, other monuments) used as a basis for accepting. If not accepted or if nothing was found, state evidence used as basis for establishing location. If reestablished through lost corner proportionate methods, indicate all monuments, distances and directions used to establish. Indicate type of monument found or set and sign post.

1863 - William Daugherty - 39.99 ch. set post.
Original B.T.'s Birch 8" S 38° E 28 lks.
Birch 10" N 57° W 23 lks.

1895 - Dorr - (Book 2 Page 10) finds Daugherty's post
New B.T.'s Birch 8" S 5½° E 8 3/4
Birch 10" N 1¼° E 15½

1988 - Soder - Found no evidence of original post or Dorr's new B.T.'s. Proportioned between NW Section corner and position of NE Section corner. Set Oneida County aluminum capped monument stamped to identify corner. Made new B.T.'s. Plastic sign post set 0.90 feet NE of corner.

(c) (d) (e) Plan view of corner with ties to at least 4 witness monuments. If in disagreement with previously established corner, show the distances between the two corners and also indicate the ties to the disputed corner.

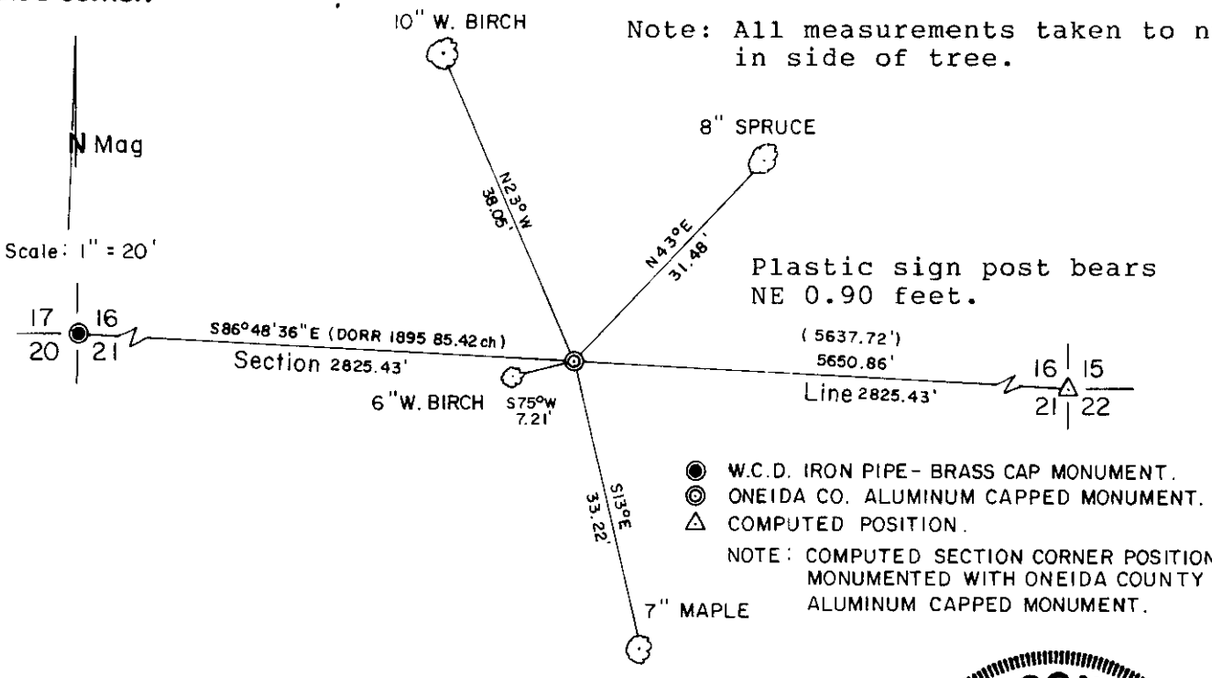

(i) I, Kip W Soder R.L.S. #1731 (type or print name) certify that the corner location on this record was determined by me or under my direction and control and that this U.S. Public Land Survey Monument Record is correct and complete to the best of my knowledge and belief.

Kip W. Soder 5/9/01

Signature Date

WISCONSIN KIP W. SODER S-1731 THREE LAKES, WI LAND SURVEYOR

Index No. N-11

380916 0020

Stamp