U.S. PUBLIC LAND SURVEY MONUMENT RECORD

Note: This form is intended and designed to fulfill all requirements of Wisconsin Administrative Code, Chapter A-E 7.08 U.S. Public Land Survey Monument Record (3)(a-i).

(a) CORNER LOCATION
Cor. of Secs. 17, 18, 19 & 20
Township 38 North
Range 9 East of the 4th P.M.
Town of Sugar Camp
County of Oneida

WISCRS - Oneida County
N: 214,446.69 USft
E: 266,060.96 USft
Datum: NAD 83(2011)
GNSS Method: RTN - Direct
GNSS Control: WISCORS VRS

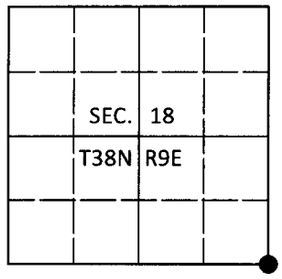

(b) HISTORY OF ORIGINAL CORNER ESTABLISHMENT

Original Surveyor: William E. Daugherty

Original Accessories:

Date of Survey Commenced: Sep. 14, 1863
Completed: Sep. 21, 1863

Birch 8" S37°W, 29 lks.
Birch 8" N63°E, 49 lks.

(b)(f)(g)(h) Description of monument found at this corner and if it was accepted, state all evidence (material, testimonial, occupational, plats, records, other monuments) used as a basis for accepting. If not accepted or if nothing was found, state evidence used as basis for establishing location. If re-established through lost corner proportionate methods, indicate all monuments, distances and directions used to establish. Indicate type of monument and sign post found or set.

Sep. 8, 1994: On OCS Map No. B-2982, Stuart L. Foltz, PLS identifies corner as "WCD brass capped iron pipe" with the following accessories: 9" w. birch S86°E, 25.89' and 8" w. birch N5°W, 25.06'

July 30, 2020: I found and accepted the record monument, a 2.4" diam. iron pipe with a 3.0" diam. unmarked WCD brass cap projecting 24" above the ground surface. Both of Foltz's bearing trees are gone. I found or established accessories as shown below. I set a white vinyl sign post bearing North, 0.8 ft.

The coordinate value shown has been verified by at least one of the following methods: 1) comparison to a previously GPS determined published value; 2) the value is the average of two or more GPS observations at a markedly different time; 3) one or more distances were measured back to the GPS observed corner from temporary GPS observed offset locations.

REGISTER OF DEEDS OFFICE
ONEIDA COUNTY
FILED

SEP 04 2020

KYLE J. FRANSON
REGISTER OF DEEDS

(c)(d)(e) Plan view of corner with ties to at least 4 witness monuments. If in disagreement with previously established corner, show the distances between the two corners and also indicate the ties to the disputed.

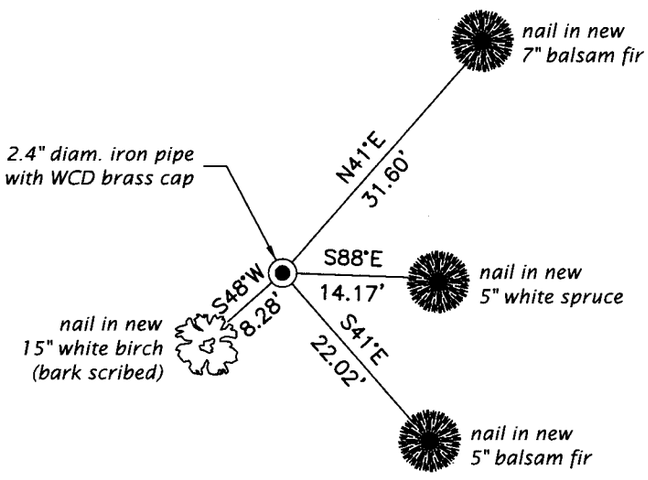

Magnetic
1" = 20'

(i) I, Jeffrey W. Austin, Professional Land Surveyor No. S-1885, hereby certify that the corner location on this record was determined by me or under my direction and control and that this U.S. Public Land Survey Monument Record is correct and complete to the best of my knowledge and belief.

Signature

AUG. 27, 2020
Date

3809180000 (INDEX NO. N-5)