

U.S. PUBLIC LAND SURVEY MONUMENT RECORD

Note: This form is intended and designed to fulfill all requirements of Wisconsin Administrative Code, Chapter A-E 7.08 U.S. Public Land Survey Monument Record (3) (a) (b) (c) (d) (e) (f) (g) (h) (i). An additional sheet may be added if necessary to conform with said requirements.


(a) Corner location: Township 38 North Corner: South 1/4 Corner

Section 19 Range 9 East Original Surveyor: William Daugherty

Town/City/Village Sugar Camp

Original B.T.'s: 6" Spruce N05°W 251ks
6" Spruce S12°W 131ks

County Oneida

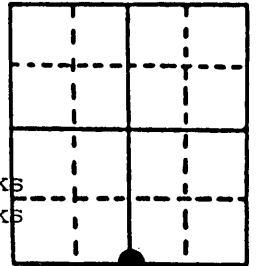


Original Survey Date: September 1863 ● Location

(b) (f) (g) (h) Description of monument found at this corner and if it was accepted, state all evidence (material, testimonial, occupational, plats, records, other monuments) used as a basis for accepting. If not accepted or if nothing was found, state evidence used as basis for establishing location. If reestablished through lost corner proportionate methods, indicate all monuments, distances and directions used to establish. Indicate type of monument found or set and sign post.

Found and accepted a standard 2" dia. iron pipe monument with stamped WCD brass cap 8" above grade at this corner location; also found an old 6" squared top corner marker post with a faint scribe on SE face 7" NW of corner monument, which is 24' North of the centerline of an old unimproved narrow gauge railroad bed, now about 16' wide and used for vehicular and pedestrian travel. Corner location visibility is ideal for future GPS positioning. I set a standard white poly 'T' corner marker post and an older 2" square wood stake together along North side of corner monument. A deep narrow drainage ditch exists along both sides of the roadway bed. In 1956, Kowalke set the brass capped iron pipe at original GLO corner and he marked new BTs 4" Spruce S22°E 0.947 chains and 4" Tam S34°W 0.862 chains; both now gone. This recovery completed September 24, 1997 and witnessed by caretaker of adjacent T.A. Solberg, Inc. property, who pointed out the corner monument to me the previous day. All original GLO survey corner evidence is now obliterated or of unreliable condition.

(c) (d) (e) Plan view of corner with ties to at least 4 witness monuments. If in disagreement with previously established corner, show the distances between the two corners and also indicate the ties to the disputed corner.

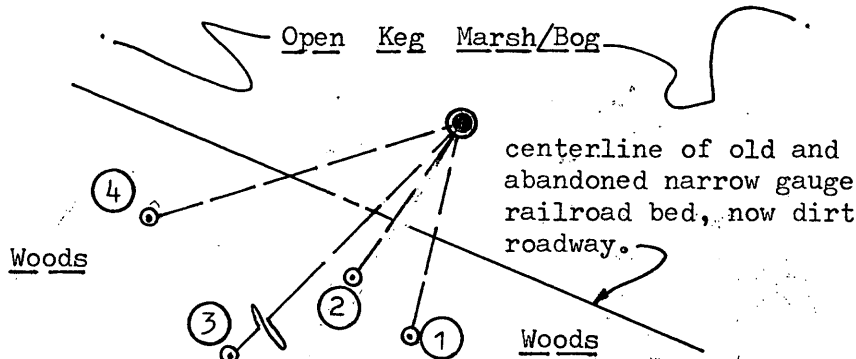


Witness Monument Ties:

- ① Record BT 9" Spruce S15°W at 46.27', by WCD; upper face blaze open and plain.
- ② New BT 7" Tam S37°W 39.97'.
- ③ New BT 7" Tam S45°W 76.81'.
- ④ New BT 6" Tam S74°W 67.88'.

Unless otherwise indicated, all BT witness monument ties are to a 1/4" dia. by 2.5" long PK nail with 1.25" dia. steel washer set in unblazed right face bark; and a PK nail with 2" dia. steel washer stamped BT also set in unblazed front face bark of each BT at DBH. All previous corner recovery notes from Wisconsin DNR and/or Oneida County survey records.



Scale: 1" = 40'

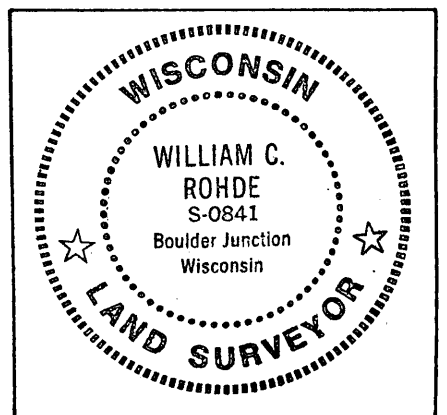

(i) I, William C. Rohde, RLS 841
(type or print name) certify that the corner location on this record was determined by me or under my direction and control and that this U.S. Public Land Survey Monument Record is correct and complete to the best of my knowledge and belief.


William C. Rohde
Signature

9-29-97
Date

Index No. R 3

3809190020

REGISTER OF DEEDS OFFICE
ONEIDA COUNTY, WIS.

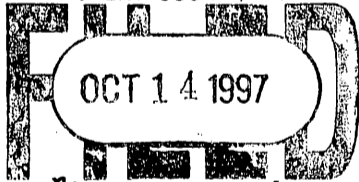

At 8:00 O'clock a M
THOMAS H. LEIGHTON
REGISTER OF DEEDS