

CERTIFIED LAND CORNER RESTORATION


Index No. **P-23**

State of Wisconsin

County of Oneida } ss.

I Phillip F. Hansen, do hereby certify that on the 13th day of July, 1977, I found evidence of the C 1/4 corner of Section 24 Township 38 North, Range 9 East, Fourth Principal Meridian, as described hereon; and that from this evidence I established a new monument and accessories as described hereon to perpetuate the original location of this corner.

Resident witnesses:
Jim Clafflin
Herb Wagoner

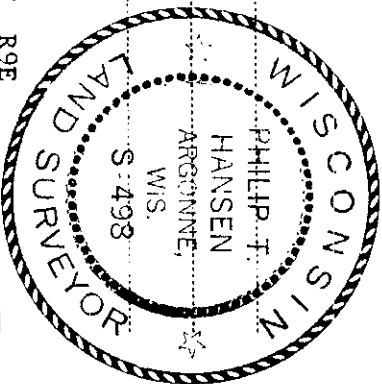

History of original corner establishment:
Corner established by N. Loftus, Ripco Surveyor, in 1956. Ran the N-S and E-W 1/4 lines to establish the C 1/4 corner at 31.47 chains east of the W 1/4 corner and 31.61 chains west of E 1/4 corner.
Marked BTs - Hemlock 5" S20°W, 64 links and Soft Maple 12" N2°W, 33 links.
True bearing of line N89° 14' 30" E.

Description of corner evidence found:

Recovered 2" iron pipe with 4" brass cap, stamped:
In checking the cross ties to BTs it was found the corner had been moved. From bearings and distances from recovered BTs the old hole where monument was originally set was found.
Recovered CRTs - Hemlock 5" (f") S20°W, 64.0 links, scribing not legible. C 1/4 S24
Sugar 12" (18") N2°W, 33.0 links, scribing grown over. RIFCO

Description of monument and accessories I established to perpetuate the original location of this corner.
Reset monument in its original position. This is S30°W, 18.3 links from the erroneous position.
Marked NBT - Red fine 6" S38°E, 14.7 links, scribed 1/4 BT.
Monument projects 30" above ground.


Dated at Rhineland, Wis., this 18th day of July, 1977

Signature *Phillip F. Hansen* Title Registered Land Surveyor Registration No. S-498
(County Surveyor, Registered Land Surveyor, or other duly authorized official)

Office of Register of Deeds, County of Oneida
Instrument was filed in this office for record on the 21st day of August, 1977
at 9:00 o'clock a.m.

Doris Verage Kuehn
(Register of Deeds)

By: Deputy

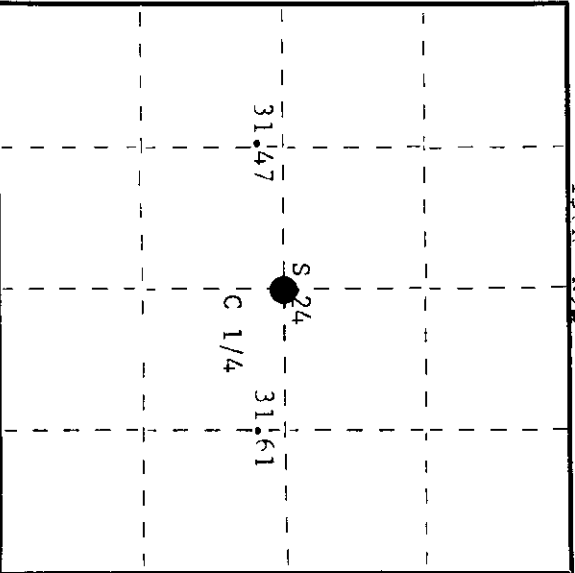

○ = Corner monument restored.