

CERTIFIED LAND CORNER RESTORATION

Index No. U-1

State of Wisconsin

County of Oneida

} ss.

I Philipp T. Hansen, do hereby certify that on the 20th day of January, 1978, I found evidence of the S 1/16 corner of Section 25 & 30


Township 38 North, Range 9 & 10 East, Fourth Principal Meridian,

as described hereon; and that from this evidence I established a new monument and accessories as described hereon to perpetuate the original location of this corner.


Resident witnesses:

Jim Clafflin

Herb Wagoner

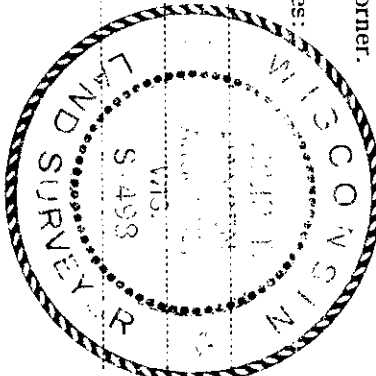

T38N R10E

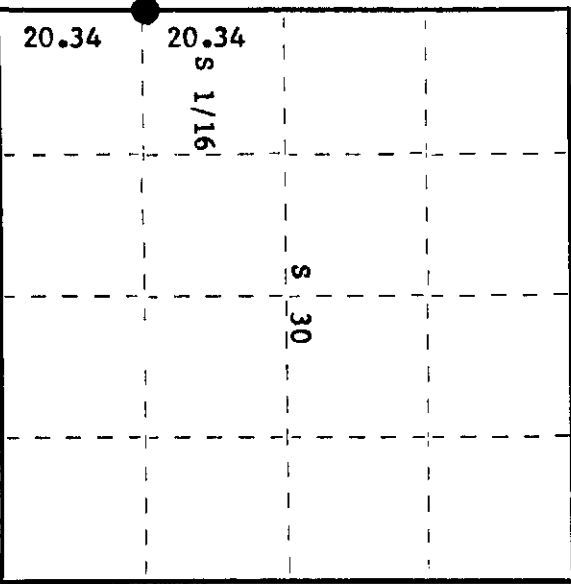

○ = Corner monument restored.

History of original corner establishment:

Corner recovered by N. Loftus, Ripco Surveyor, in 1956. Ran random line north from section corner 30, 31, 36, 25 at 20.23 1/2 chains. Recovered Vaughan's S 1/16 corner, continued north at 40.47 chains, tied into Vaughan's 1/4 corner. Marked NBT's at S 1/16, Black Spruce 3" S85°E, 33 links and Black Spruce 4" N6°E, 44 links.

Description of corner evidence found:

- Recovered 1" iron pipe with 2" brass cap, stamped: S 1/16
- Monument projects 24" above ground. S25 + S30
- Recovered OBT's - Black Spruce 3" (5") S85°E (S80°E), 33.0 links (33.6 links), scribbled 1/16 S30 BT.
- Black Spruce 4" (5") N6°E, 44.0 links (43.0 lks), 38R9 38R10 scribbled 1/16 BT. RIPCO

Description of monument and accessories I established to perpetuate the original location of this corner. Monument recovered in good condition, left in place as recovered. No additional accessories established.

Dated at Rhinelander, Wis., this 24th day of January, 1978

Signature Philipp T. Hansen Title Registered Land Surveyor Registration No. S-498  
(County Surveyor, Registered Land Surveyor, or other duly authorized official)

Office of Register of Deeds, County of Oneida. I hereby certify that the within instrument was filed in this office for record on the 16th day of February, 1978 at 9:30 o'clock P. M.

Dorice George Kuehn  
(Register of Deeds)

By: \_\_\_\_\_ Deputy

380925/000