

CERTIFIED LAND CORNER RESTORATION

Index No. **U-23**



State of Wisconsin

County of \_\_\_\_\_ } ss.

I \_\_\_\_\_, do hereby certify that on the \_\_\_\_\_ day of \_\_\_\_\_, 19\_\_\_\_, I found evidence of the \_\_\_\_\_ corner of \_\_\_\_\_ Township \_\_\_\_\_ North, Range \_\_\_\_\_ Fourth Principal Meridian,

as described hereon; and that from this evidence I established a new monument and accessories as described hereon to perpetuate the original location of this corner.

Resident witnesses:

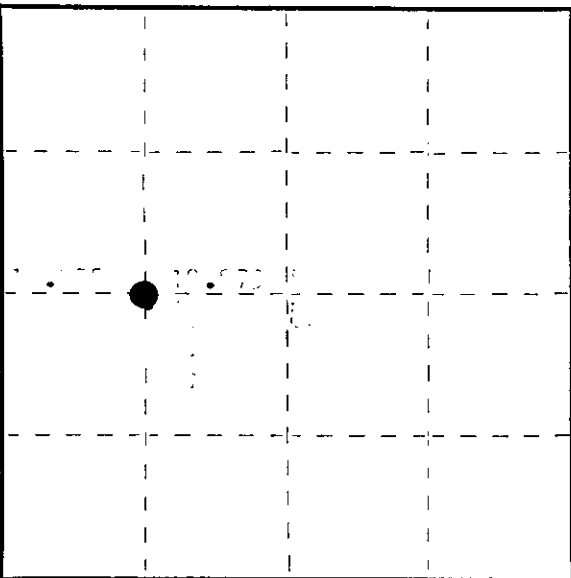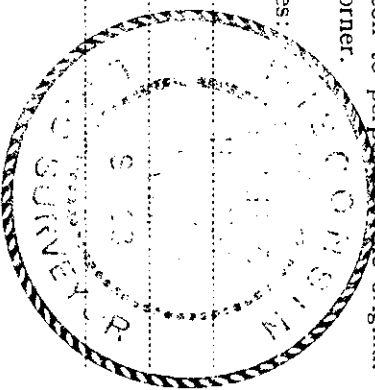

○ = Corner monument restored.

History of original corner establishment:

Description of corner evidence found:

Description of monument and accessories I established to perpetuate the original location of this corner.

Dated at \_\_\_\_\_ Wis., this \_\_\_\_\_ day of \_\_\_\_\_, 19\_\_\_\_

Signature *Paul J. Stemann* Title \_\_\_\_\_ Registration No. \_\_\_\_\_  
(County Surveyor, Registered Land Surveyor, or other duly authorized official)

Office of Register of Deeds, County of \_\_\_\_\_  
Instrument was filed in this office for record on the \_\_\_\_\_ day of \_\_\_\_\_, 19\_\_\_\_  
at \_\_\_\_\_ o'clock \_\_\_\_\_ M. *Paul J. Stemann* hereby certify that the within

*Debra Clark*  
(Register of Deeds)

By \_\_\_\_\_ Deputy