


CERTIFIED LAND CORNER RESTORATION

Index No. 7-23


State of Wisconsin

County of } ss.

I do hereby certify that on the ... day of ... 19... I found evidence of the ... corner of ... North, Range ... Fourth Principal Meridian, as described hereon; and that from this evidence I established a new monument and accessories as described hereon to perpetuate the original location of this corner.

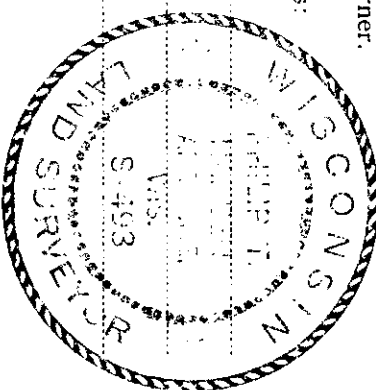

Resident witnesses:

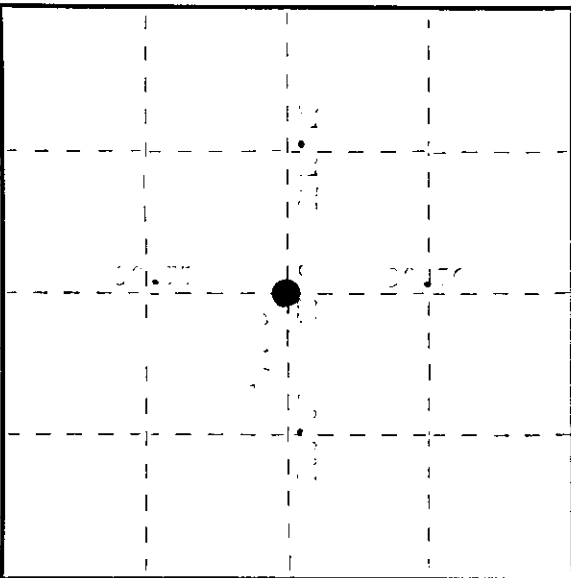

○ = Corner monument restored.

History of original corner establishment:

Description of corner evidence found:

Description of monument and accessories I established to perpetuate the original location of this corner.

Dated at ... Wis., this ... day of ... 19...

Signature of ... Title ... Registration No. ...

Office of Register of Deeds, County of ... I hereby certify that the within instrument was filed in this office for record on the ... day of ... 19...

By ... (Register of Deeds) Deputy

3809252020