

State of Wisconsin

County of Oneida



ss.

I Phillip T. Hansen, do hereby certify that on the 12th day of January, 1978, I found evidence of the Quarter corner of Section 25 & 26 Township 38 North, Range 9 East, Fourth Principal Meridian, as described hereon; and that from this evidence I established a new monument and accessories as described hereon to perpetuate the original location of this corner.

Resident witnesses:

Jim Claffin

Herb Wagoner

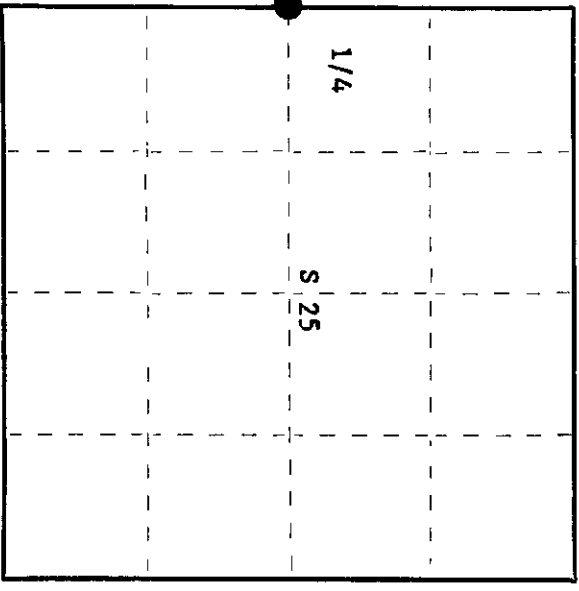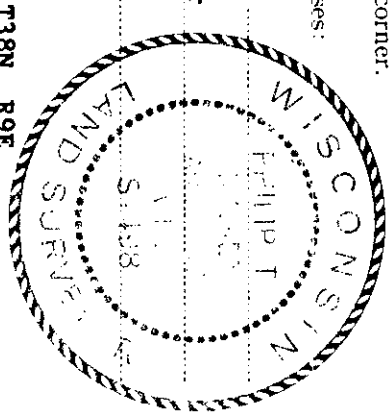

○ = Corner monument restored.

History of original corner establishment:

N. Loftus, Ripco surveyor, recovered a corner here in 1959 which he believed to have been set by B.F. Dorr. This sets in a fence corner. Set 2" iron pipe with 4" brass cap. Used this corner to run section line south to SW corner and also to run E-W 1/4 line.

Description of corner evidence found:

Recovered 2" iron pipe with 4" square brass cap. Also found an old 3" square cedar post beside it, no evidence of scribe marks. Fence runs south and west from this corner. No evidence of any BT's recovered. No notes on record.

Description of monument and accessories I established to perpetuate the original location of this corner.

Monument left in place as recovered. Cap stamped: Monument projects 20" above ground.

Marked NBT's - Red Pine 5" S82°E, 38.2 links, scribed 1/4 BT. Black Spruce 6" N70°W, 40.0 links, scribed 1/4 BT. Black Spruce 6" S74°W, 39.9 links, scribed 1/4 BT.

T38N R9E

S26 S25

RIPCO

Dated at Rhinelanders, Wis., this 19th day of January, 1978

Signature: Phillip T. Hansen, Title: Registered Land Surveyor, Registration No. S-498 (County Surveyor, Registered Land Surveyor, or other duly authorized official)

Office of Register of Deeds, County of Oneida, at 9:30 o'clock A.M. I hereby certify that the within instrument was filed in this office for record on the 6th day of February, 1978.

Deane Leage Kuehn (Register of Deeds)

By: Deputy