

CERTIFIED LAND CORNER RESTORATION



Index No. V-17

State of Wisconsin } ss.
County of Oneida

History of original corner establishment:
N. Loftus, Ripco surveyor, recovered this corner in 1960. When he ran random line north from SE corner found a 1/4" x 1 1/2" piece of flat iron driven in centerline of Lilly Bass Road. Calls from south to existing 1/4 corner and N 1/16 corner found to be O.K.

I, Phillip T. Hansen, do hereby certify that on the 25th day of October, 1978, I found evidence of the Section Corner corner of 26, 27, 34, 35 Township 38, North, Range 9 East, Fourth Principal Meridian, as described hereon; and that from this evidence I established a new monument and accessories as described hereon to perpetuate the original location of this corner.

Resident witnesses:
Jim Clafin
Herb Wagoner
John Masbaum

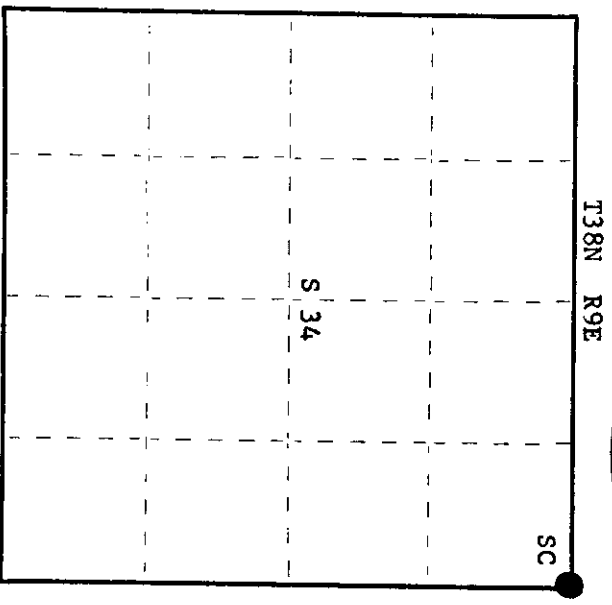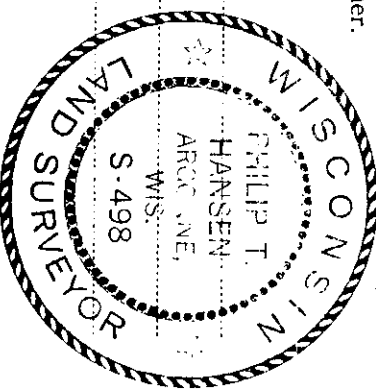

○ = Corner monument restored.

Description of corner evidence found:

Recovered 1/4" x 1 1/2" flat iron driven in centerline of Lilly Bass Road. Witness corner set by Loftus did not fit too good.
No evidence of any BR's recovered.
Ripco's witness corner, 2" iron pipe with 4" brass cap, recovered. Stamped: T38N R9E S27 + S26 S34 + S35 Cor. 30 lks. N RIPCO

Description of monument and accessories I established to perpetuate the original location of this corner.

Reset Ripco's witness monument at 30 links.
Monument projects 2 1/2' above ground.
NBR's - Maple 6" S39°W, 58.4 links
R.Pine 8" S24°W, 117.8 links
Power Pole #3809-26L34 N63°E, 66.7 links
All measurements to true corner

Dated at Rhinelander, Wis., this 4th day of October, 1978

Signature Phillip T. Hansen Title Registered Land Surveyor Registration No. S-498
(County Surveyor, Registered Land Surveyor, or other duly authorized official)

Office of Register of Deeds, County of Oneida
at 150 o'clock P. M. 16th day of October, 1978
I hereby certify that the within

Dorcas Verage Kuehn
(Register of Deeds)

By: _____ Deputy

3809270000