

CERTIFIED LAND CORNER RESTORATION



Index No. **V-16**

State of Wisconsin }
County of Oneida } ss.

I, Phillip T. Hansen, do hereby certify that on the 4th day of October, 1978, I found evidence of the E 1/16 corner of Sections 27 & 34 Township 38, North, Range 9 East, Fourth Principal Meridian, as described hereon; and that from this evidence I established a new monument and accessories as described hereon to perpetuate the original location of this corner.

Resident witnesses:

Jim Clafflin
Herb Wagoner
John Masbaum

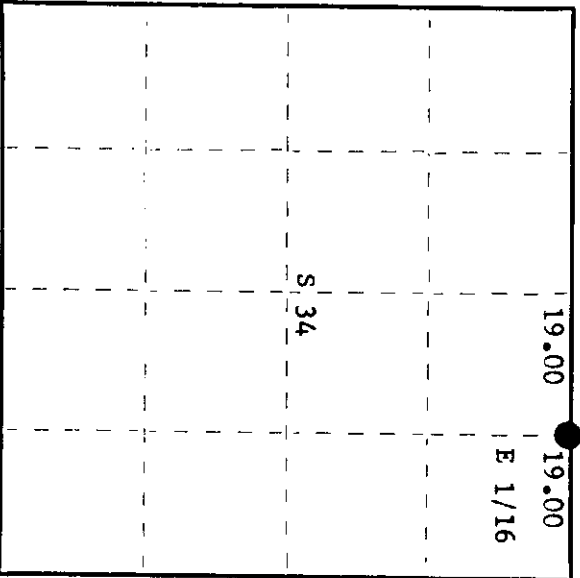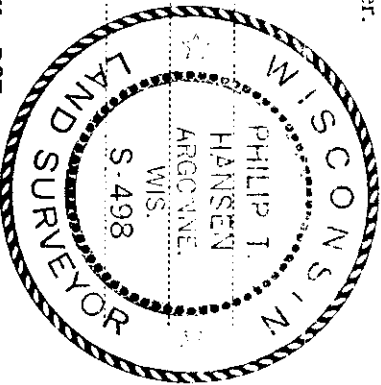

○ = Corner monument restored.

History of original corner establishment:

Corner established by N. Loftus, Ripco surveyor, in 1960.
Ran random line west bearing S 86° 20' W 38.00 chains to close out at 1/4 corner.
Recovered pin in the road.
Set E 1/16 corner at 19.00 chains intermediate.
Marked NBT's - Red Maple 4" N41°W, 63 links
White Pine 5" S34°W, 79 links

Description of corner evidence found:

Recovered 3/4" iron pipe in centerline of Lilly Bass Road, 6 inches below the surface.
Recovered White Pine 5" (12") S34°W, 79.0 links (78.5 links), scribing partly visible.
Maple 4", now a rotted stump.

Description of monument and accessories I established to perpetuate the original location of this corner.

Set a 1" iron pipe with 2" brass cap projecting 24". Cap stamped:
for witness corner 60 links north.
Marked NBT - Maple 7" S26°E, 81.0 links, scribed 1/16 BT.

T38N R9E
E 1/16 S 4/27 W.C.
S 60 lks.

Dated at Rhineland, Wis., this 4th day of October, 1978

Signature Phillip T. Hansen Title Registered Land Surveyor Registration No. S-498
(County Surveyor, Registered Land Surveyor, or other duly authorized official)

Office of Register of Deeds, County of Oneida
Instrument was filed in this office for record on the 18th day of October, 1978
at 1:50 o'clock P. M. I hereby certify that the within

Dorrie Verge Kuehn
(Register of Deeds)

By: _____ Deputy