

CERTIFIED LAND CORNER RESTORATION

Index No. Y-13

State of Wisconsin

County of Oneida } ss.



I, Phillip T. Hansen, do hereby certify that on the 12th day of August, 1977, I found evidence of the S 1/16 corner of Sec. 33 & 34 Township 38 North, Range 9 East, Fourth Principal Meridian,

as described hereon; and that from this evidence I established a new monument and accessories as described hereon to perpetuate the original location of this corner.

Resident witnesses:

Jim Clafflin

Herb Haagoner

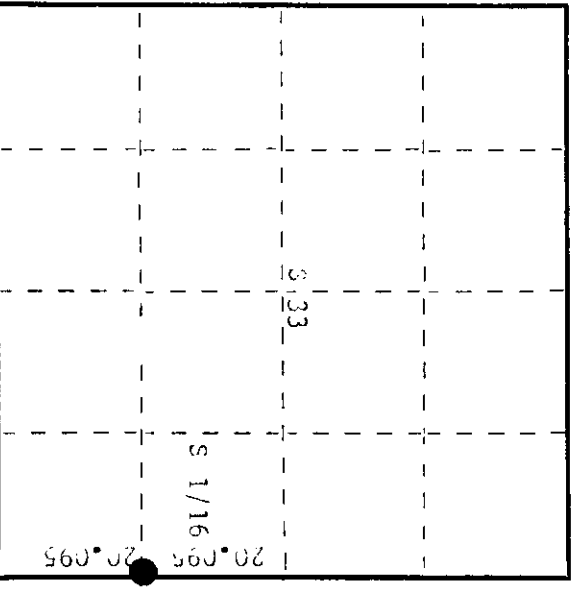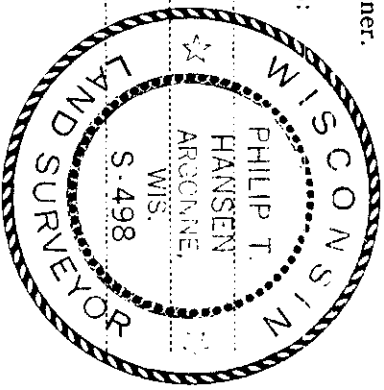

History of original corner establishment:

Corner established by N. Loftus, Pinco Surveyor, in 1960. Ran random line south from W 1/4 corner Section 34 at 44.10, closed out 64 links west of SW corner. Set S 1/16 corner at 22.095 chains 34 links east. Marked NRTs - Red Maple 3rd N43°E, 72 links Red Maple 4th N15°W, 07 links

Description of corner evidence found:

Recovered 1" iron pipe with 2" square brass cap projecting 24" above ground. Cap stamped: Monument securely in ground. Recovered CBTs - Red Maple 4th (60° N15°E, 07 links, S 1/16 scribbling ground over. Red Maple 4th (60° N43°E (347')) 72 links. RIFCC

Description of monument and accessories I established to perpetuate the original location of this corner.

As monument was secure in ground, it was left as recovered. Marked NRT - Red Pine 6th S23°E, 99.2 links, scribbled 1/16 RT.

Dated at Oneida, Wis., this 26th day of August, 1977.

Signature: Phillip T. Hansen, Title: Registered Land Surveyor, Registration No. S-498 (County Surveyor, Registered Land Surveyor, or other duly authorized official)

Office of Register of Deeds, County of Oneida. Instrument was filed in this office for record on the 13th day of September, 1977 at 4:00 p.m. I hereby certify that the within

By: Bruce Tenaberger, (Register of Deeds)

O = Corner monument restored.