

CERTIFIED LAND CORNER RESTORATION

Index No. **X-13**

History of original corner establishment:


Corner established by N. Loftus, Pineo Surveyor, in 1960. Ran random line 191' 25" mag. from Section Corner 27, 29, 34, 33. Closed out .0875 chains west of Dorr's N 1/16 corner at 22.21 chains. Continued south on corrected bearing S 11° 08' W 22.21 chains to set N 1/4 corner.
 Marked NPTs - Red Pine 10" N69°W, 74 links.
 Red Pine 12" S83°E, 95 links.

Description of corner evidence found:

Recovered 2" iron pipe with 3" square brass cap in excellent condition. Cap stamped:
 Monument projects 22" above ground.
 Recovered OPTs - Red Pine 10" (14") N60°W, 74.0 links,
 scriber S33 38-0 BT.
 Red Pine 12" (15") S83°E, 95.0 links,
 scriber grove over.
 T38P POF
 TFCO


Description of monument and accessories I established to perpetuate the original location of this corner.

Marked NPT - Mark's 12" N14°W, 90.8 links, scriber 1/4 BT.

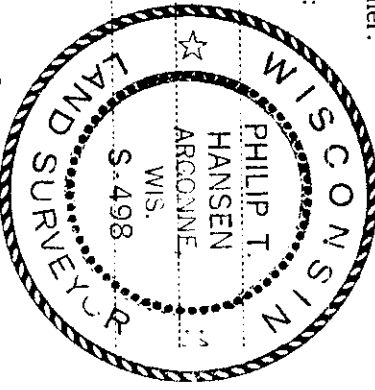

State of Wisconsin } ss.
 County of Oneida }

Resident witnesses:
 Jim Clafflin
 Herb Yagone

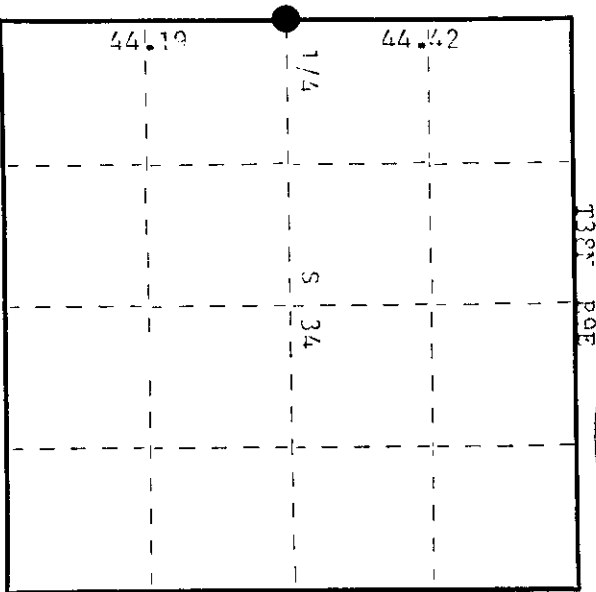

O = Corner monument restored.

Dated at Rhinelander, Wis., this 20th day of August, 1977.

Signature: *Philip T. Hansen* Title: Registered Land Surveyor Registration No. S-498
 (County Surveyor, Registered Land Surveyor, or other duly authorized official)
 Office of Register of Deeds, County of Oneida
 Instrument was filed in this office for record on the 13th day of August, 1977 at 11:00 o'clock A.M.
 I hereby certify that the within instrument was filed in this office for record on the 13th day of August, 1977 at 11:00 o'clock A.M.

Doris Teraga Husk
 (Register of Deeds)

By: _____ Deputy