

CERTIFIED LAND CORNER RESTORATION

Index No. **Y-15**



State of Wisconsin

County of Oneida } ss.

I Philip T. Hansen, do hereby certify that on the 19th day of August, 1977, I found evidence of the SE 1/16 corner of Section 34 Township 38, North, Range 4 East, Fourth Principal Meridian, as described hereon; and that from this evidence I established a new monument and accessories as described hereon to perpetuate the original location of this corner.

Resident witnesses:

Jr Craftin
Herb Wagoner

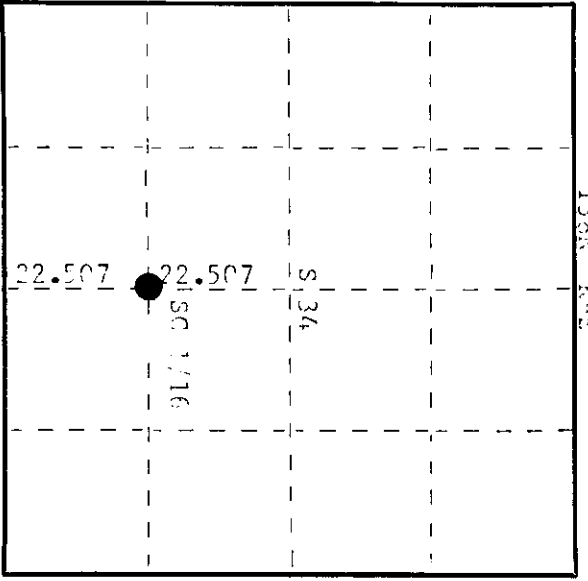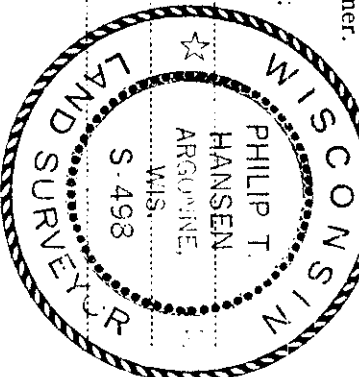

○ = Corner monument restored.

History of original corner establishment:

Corner established by N. Loftus, Sisco Surveyor, in 1960. Ran random line south from previously established N 1/4 corner to S 1/4 corner. Ran E-W 1/4 line to establish the C 1/4 corner.
Set SC 1/16 at 22.5075 chains intermediate. Set iron pipe and marked BTs - Norway Pine on N11°N, 1.13 chains
Black Spruce on S29°W, 77-3/4 links

Description of corner evidence found:

Recovered iron pipe with a 2" square brass cap projecting 24" above ground. Cap stamped: Iron pipe was bent over, removed same and straightened it.
Recovered CRTs - Black Spruce on S29°N (S34°E) 77.75 links (78.0 lks). T38N R9E
Norway Pine on (12°) N11°E (N14°E) 1.13 chains, SC 1/16 S24
scribed 1/16 S34 W. N11CC

Description of monument and accessories I established to perpetuate the original location of this corner.
Drove a 3/4" iron pipe beside the straitened monument.
No additional accessories established.

Dated at Rhinelander, Wis, this 29th day of August, 1977

Signature Philip T. Hansen Title Registered Land Surveyor Registration No. S-498
(County Surveyor, Registered Land Surveyor, or other duly authorized official)

Office of Register of Deeds, County of Oneida, I hereby certify that the within instrument was filed in this office for record on the 13th day of September, 1977 at 4:02 o'clock P. M.

Debra W. Kuehn
(Register of Deeds)

By _____ Deputy

380934/020