



State of Wisconsin

County of Oneida } ss.


Resident witnesses:

Jim Clafflin
Merv Hanson

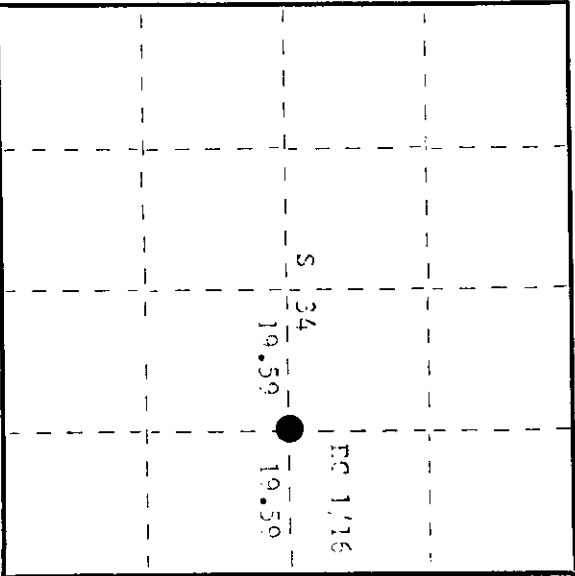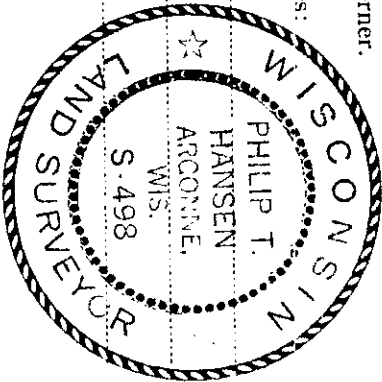

O = Corner monument restored.

History of original corner establishment:


Description of corner evidence found:

Set 1" iron pipe and marked RTs:
White Fine 8" S35°E, 36 1/2 links
White Fine 7" N87°W, 22 links

Description of monument and accessories I established to perpetuate the original location of this corner.

Recovered 1" iron pipe with 2" brass cap projecting 2" above ground. Cap stamped:
Recovered CRTs - White Fine 7" (0.0) set 0.0, 22.0 links (22.0 RTs).
White Fine 8" S35°E, 36.5 links, set 0.0
CE 1/16 S34 RT.
T38N R9E
E 1/16

C - S34
RTPCC

Dated at Rhineland, Wis., this 29th day of August, 1977

Signature: [Signature] Title: Registered Land Surveyor Registration No. S-498
(County Surveyor, Registered Land Surveyor, or other duly authorized official)

Office of Register of Deeds, County of Oneida
Instrument was filed in this office for record on the 13th day of September, 1977
at 4:08 o'clock P.M.

[Signature]
(Register of Deeds)

By: Deputy