

CERTIFIED LAND CORNER RESTORATION

Index No. **A-21**

3809350000

History of original corner establishment:

Corner recovered by H. Loftus, Hydro Surveyor, in 1950. Set new post and marked NBT - red line 14" 10° 47.7 links.

State of Wisconsin





Resident witnesses:

Jill Martin

Harb ...

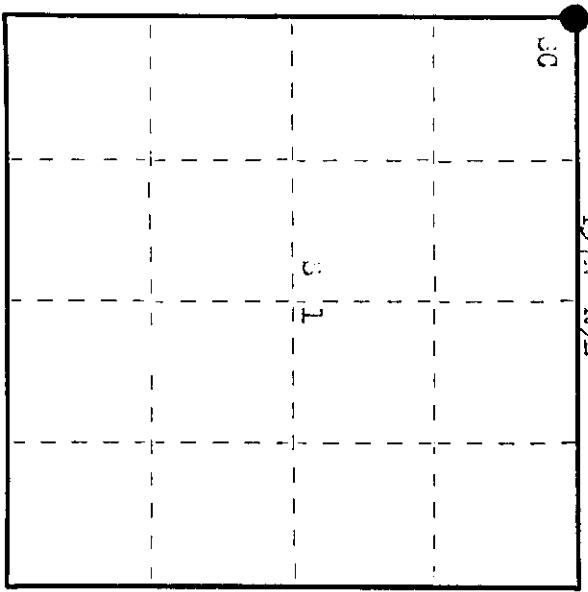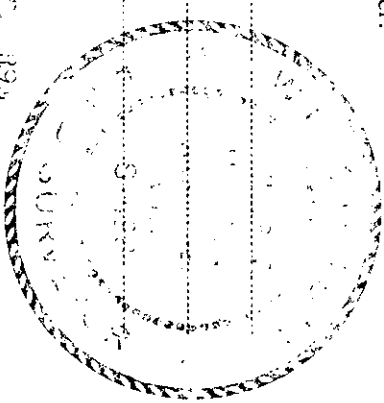

○ = Corner monument restored.

Description of corner evidence found:
 recovered 2 1/2" iron pipe with 4" square brass cap standing;
 monument recovered in good condition.
 Recovered NBT - red line 14" 10° 47.7 links, scribble not legible.
 192 38.
 35 | 30
 2 | 1
 1976

Description of monument and accessories I established to perpetuate the original location of this corner, as monument was recovered in good condition, in the lot in place.
 monument projects 4" above ground.
 NBTs - red line 6" 10° 47.7 links, scribble not legible.
 All distances made to center of NBTs.


Signature Phillip T. Hansen Title Registered Land Surveyor, or Registered Land Surveyor, or other duly authorized official Registration No. 4428
 (County Surveyor, Registered Land Surveyor, or other duly authorized official)


 (Register of Deeds)

By: _____ Deputy