

CERTIFIED LAND CORNER RESTORATION

State of Wisconsin

County of Oneida

ss.

I Jean F. Resvick, do hereby certify that on the 10 day of Nov. 1980, I found evidence of the East Quarter corner of section 35 Township 38 North, Range 9 East, Fourth Principal Meridian, as described hereon; and that from this evidence I established a new monument and accessories as described hereon to perpetuate the original location of this corner:



Description of original monument and accessories and subsequent restorations:
 Dependent resurvey of 1960 by H.B. Crawford reports corner found marked with an iron pipe, 1 inch in diameter, projecting 6 inches above the ground. Pipe being in line with a fence bearing S 87°44' W and 39 links east from the southeast corner of the fence.
 The 1960 Dependent Resurvey left the pipe in place and blazed and scribed the following bearing trees:
 Poplar 5, N 50 3/4 E, 28 1/2 links distance.
 Poplar 0, N 1 1/4 E, 57 links distance.

Description of corner evidence found:
 I found 1 inch diameter iron pipe, 6 inches above the ground with fence corner 39 links west of pipe. Pipe is in line with the fence which is now down.
 Aspen stump, cut off above scribe, bears N 1°31' E, 37.62 feet.
 Aspen stump, cut off above scribe, bears N 60°05' E, 18.81 feet.
 2 inch diameter iron pipe, 30 inches above ground, bears N 1°30' E, 1.6 feet.
 Alvin Keso reports that he set the 2" iron pipe as an aid in finding the corner.

Description of monument and accessories I established to perpetuate the location of this corner:
 Replaced the 1 inch diameter, iron pipe with an Oneida County Monument with cap stamped; T30N, R9E, 1/4, S35, S36, 1900, S-002

Placed the iron pipe, 1 inch in diameter and 30 inches long on the SE side of and along side of the monument.

Blazed and scribed the following new bearing trees;
 Aspen 7, S 19° 42' E, 21.78 feet.
 Aspen 0, S 50° 45' W, 32.51 feet.
 Aspen 0, N 24° 43' W, 41.00 feet.

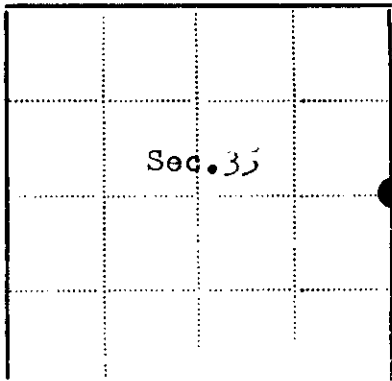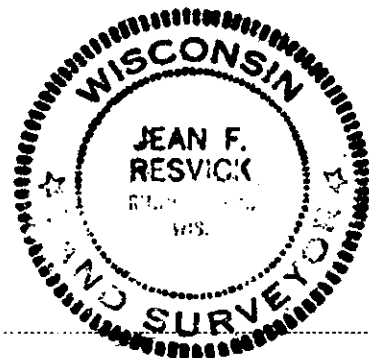

● - Corner monument restored
 □ -

Resident witnesses.....

Dated at Rhinelander Wisconsin, this 26 day of Dec. 1980.

Signature Jean F. Resvick Title R.L.S.
 (County Surveyor, Registered Land Surveyor, or other duly authorized official)

Surveyors Registration No. S- 002

Office of Reg. of Deeds County of Oneida

I hereby certify that the within instrument was filed in this office for record on the 12 day of June 1980 and was filed in Book No. Page No. of County Records.

Signature Doris Verage Kuhn Title Reg. of Deeds
Cynthia A. Davis Deputy

Township 38 North, Range 9 East, Section 35, Index No., Page No.

X-21