

CERTIFIED LAND CORNER RESTORATION

State of Wisconsin

County of Oneida

ss.

I, Jean F. Resvick do hereby certify that on the 1st day of Nov., 1980, I found evidence of the Special Meander corner of Section 35 Township 30 North, Range 9 East, Fourth Principal Meridian, as described hereon; and that from this evidence I established a new monument and accessories as described hereon to perpetuate the original location of this corner:

Description of original monument and accessories and subsequent restorations:
The Decedent survey of 1960 by H.B. Crawford established this Special Meander Corner on the East-West center line of section 35 and the East Shore of Jennie Weber Lake.

Corner was marked by a iron pipe, 20 inches long, 2 1/2 in. diam., 20 in. in the ground, with brass cap mkd. SMC, T30N, S30, R9E, 1960.

Spruce 6, bears N 57 1/2 E, 60 links.
Tamarack 6, bears S 70 1/2 E, 52 1/2 Links.
Iron Pipe, 1 inch diam., projecting 2 in. above the ground, bears N 60°33' E, 97 links dist.

Description of corner evidence found:

Tamarack 7, scribed, standing, dead
Spruce scribed, fallen
Iron pipe, 1 in. diam., 2 inches above the ground.
From these bearing trees the corner would now be in the lake in about 2 feet of water. Monument was not found.



Description of monument and accessories I established to perpetuate the location of this corner:
Established the location of the corner by projecting the line west from the East Quarter corner of section 35 as recorded and by traverse ties to the 3 witnesses found. The projected line, with recorded distance and the 3 witnesses all check to a common point for the location of the corner. I established a witness corner on the East-West center line of section 35 and 60.00 feet east on line from the corner location in the lake.

I set an Oneida county monument on line and 60.00 feet east of the Special Meander Corner, with aluminum cap stamped:

WITNESS CORNER, T 30 N, SMC, S30, R9E, 1980, S-802

I blazed and scribed the following bearing trees as references to the witness corner;

White Birch, N 25°47' E, 16.00 feet
White Pine, S 39°58' E, 22.22 feet
White Birch, S 41°02' W, 3.49 feet

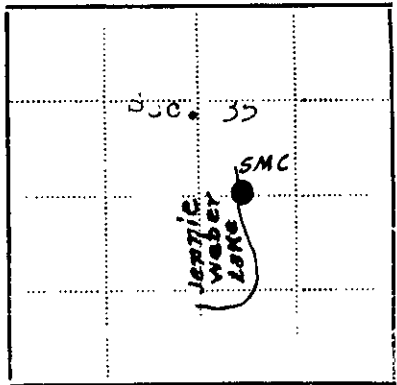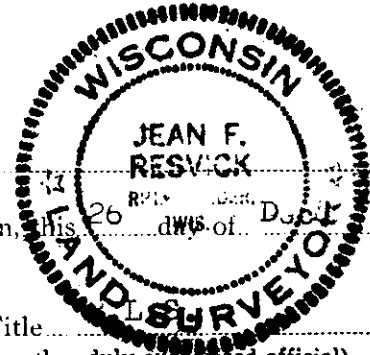

● - Corner monument restored
□ -

Resident witnesses
Dated at rhineland Wisconsin, this 26 day of Dec, 1980.
Signature: Jean F. Resvick Title: Land Surveyor
(County Surveyor, Registered Land Surveyor, or other duly authorized official)

Surveyors Registration No. S- 02
Office of Register of Deeds County of Oneida
I hereby certify that the within instrument was filed in this office for record on the 12 day of June, 1980 and was filed in Book No. Page No. of County Records.

Signature: Dora V. ... Title: Reg. of Deeds
Cynthia G. ... Deputy

Township 30 North, Range 9 East, Section 35, Index No. Page No.

X-19-20