

History of original corner establishment:

Original corner established by H.C. Fellows, Deputy Surveyor, in 1860 from which Tamarack 12" bears S 37° W 40 links, Tamarack 14" bears N 67° W 50 links, Yellow Pine 16" bears N 34° E 13 links, Birch 18" bears S 53° E 31 links.

Corner recovered by B.F. Dorr in 1894.

Corner reset by N. Loftus, Ripco Surveyor, in 1956. Recovered a corner improperly located, according to Dorr's notes. Recovered E 1/4 corner and ran random line North through Dorr's recovered N 1/16 corner, which checked Dorr's measurement. Continued north and set section corner at 17.17 1/2 chains, observed bearing N 1° 6' 50" E.

No record of bearing trees.  
Description of corner evidence found:

Recovered 2 1/2" Iron pipe with 4" square brass cap stamped:  
Monument recovered in good condition and securely in ground.  
Recovered Black Spruce 10" N 66° W 3.6 links, scribing not legible.  
Black Spruce 7" due south 73.0 links, scribing not legible.

T38N R  
9 26 13 10  
E 1 1 6 E  
T37N  
RIFCO

Description of monument and accessories I established to perpetuate the original location of this corner.

As monument was in good condition and securely in ground, it was left in place.

Monument projects 10" above ground.

NBT - Black Spruce 6" S 20° E 54.1 links

Red Pine 8" S 63° E 38.5 links, scribed SC BT.

Corner sets 50 links east of N-S logging road.

State of Wisconsin



County of **Oneida** } ss.

I **Phillip T. Hansen**, do hereby certify that on the **16th** day of **December**, 19**76**, I found evidence of the **Section** corner of **S1, 6, 36, 31** Township **37-38**, North, Range **9 & 10 East**, Fourth Principal Meridian, as described hereon; and that from this evidence I established a new monument and accessories as described hereon to perpetuate the original location of this corner.

Resident witnesses:

**Jim Clarlin**

**Harb Wagoner**

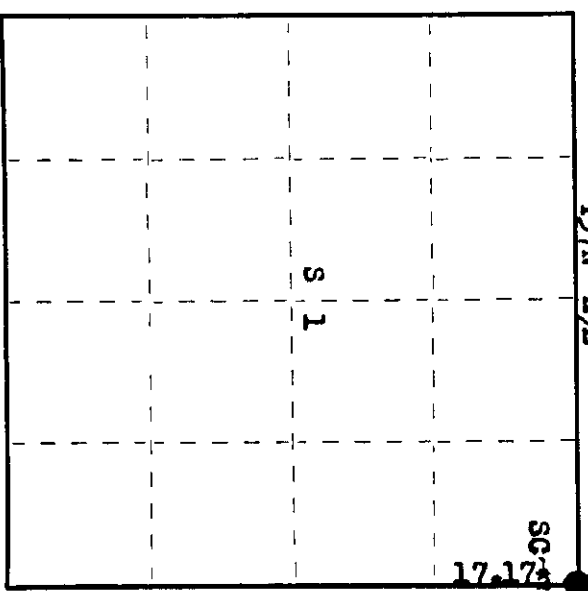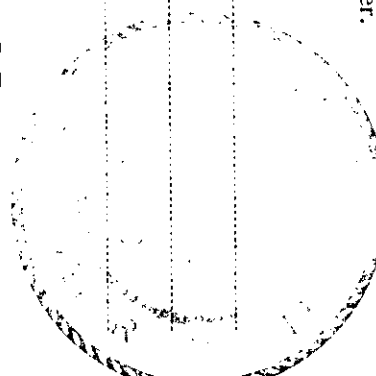

○ = Corner monument restored.

Dated at **Rhinelander**, Wis., this **22nd** day of **December**, 19**76**.

Signature **Phillip T. Hansen** Title **Registered Land Surveyor** Registration No. **S-498**  
(County Surveyor, Registered Land Surveyor, or other duly authorized official)

Office of Register of Deeds, County of **Oneida**, I hereby certify that the within instrument was filed in this office for record on the **18th** day of **February**, 19**77**, at **10:00** o'clock **A**. M.

**Loise N. Hume**  
(Register of Deeds)

By **Joseph M. Brown** Deputy

3809360000