

CERTIFIED LAND CORNER RESTORATION

Index No. A-24

State of Wisconsin } ss.  
County of Oneida

I Phillip T. Hansen, do hereby  
certify that on the 16th day  
of December, 1976, I found  
evidence of the E 1/16  
corner of Section 36 & 1  
Township 37, North, Range  
9 East, Fourth Principal Meridian,

as described hereon; and that from this evidence  
I established a new monument and accessories  
as described hereon to perpetuate the original  
location of this corner.

Resident witnesses:

Jim Claflin

Herb Wagoner

History of original corner establishment:


Corner established by N. Loftus, Ripco Surveyor, in 1956. He ran a random line N 87° 15' E from Section Corner 35, 36, 1 & 2 79.235 chains to close out 1.375 chains North of NE corner. Corrected bearing N 88° 14' E. Set E 1/16 corner at 59.42-3/4 chains equidistant between N 1/4 corner & NE section corner. Marked BTs - Tamarack 4" S 82° E 51 1/2 links and tamarack 4" S 72° W 39 1/2 links. Set iron pipe with brass cap.

Description of corner evidence found:

Recovered 1" iron pipe with 2" square brass cap stamped:  
Monument in good condition, but leaning. T38N R9E  
Recovered OBTs - Tamarack 4" S 72° W (S 22° W) (dead) E 1/16 S 1/36  
Tamarack 4" S 82° E (S 86° E) (dead) T37N R9E  
RIPCO

Description of monument and accessories I established to perpetuate the original location of this corner.  
Extracted the monument from the ground and reset it in its old location.

Monument projects 14" above ground.  
NBTs - Tamarack 4" N 74° E 64.5 links, scribed BT.  
Tamarack 4" S 52° E 80.2 links, scribed BT.  
All distances measured to center of tree.

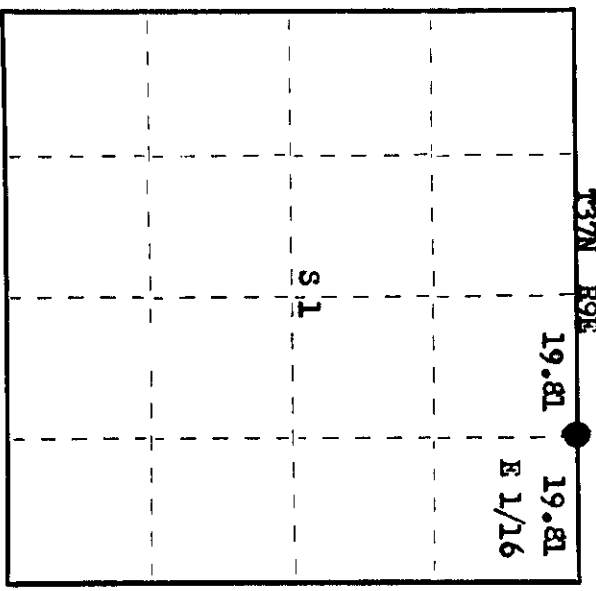

○ = Corner monument restored.

Dated at Rhinelander, Wis., this 22nd day of December, 1976

Signature Phillip T. Hansen Title Registered Land Surveyor Registration No. S-498  
(County Surveyor, Registered Land Surveyor, or other duly authorized official)

Office of Register of Deeds, County of Oneida  
Instrument was filed in this office for record on the 10th day of February, 1977  
at 10:00 o'clock AM.

Anna Bernice Tuck  
(Register of Deeds)

By Joseph M. Broome Deputy

3809360010