

CERTIFIED LAND CORNER RESTORATION

Index No. **A-22**

State of Wisconsin



County of Oconto } ss.

I Philip P. Shannon, do hereby certify that on the 10th day of October, 1970, I found evidence of the 1/4 S corner of Section 20 - 1 Township 27 N 35 W, North, Range 2 East, Fourth Principal Meridian, as described hereon; and that from this evidence I established a new monument and accessories as described hereon to perpetuate the original location of this corner.

Resident witnesses:

J. J. Griffin

W. P. ...

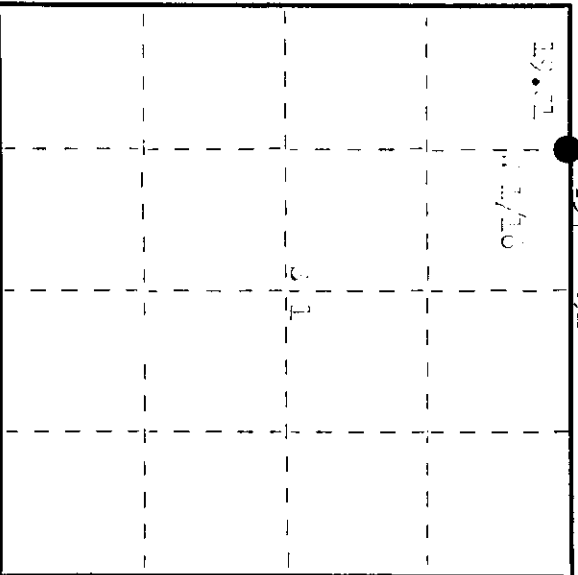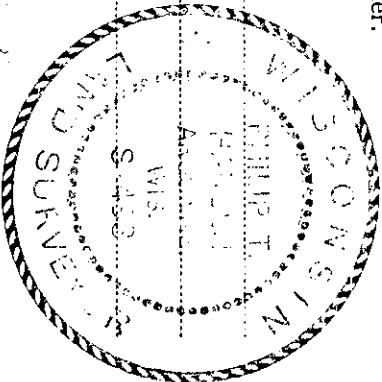

○ = Corner monument restored.

History of original corner establishment:


Description of corner evidence found:

Recovered in ... corner ... evidence found ...

Description of monument and accessories I established to perpetuate the original location of this corner.

As described in the recovered instrument, in the left ... monument ... above ground.

Dated at Oconto, Wis., this 10th day of October, 1970.

Signature Philip P. Shannon, Title Surveyor, Registration No. ...
(County Surveyor, Registered Land Surveyor, or other duly authorized official)

Office of Register of Deeds, County of Oconto, I hereby certify that the within instrument was filed in this office for record on the 10th day of October, 1970 at 9:30 o'clock A. M.

Dorice Lenage Kuehn
(Register of Deeds)

By: ... Deputy

3809360030