

CERTIFIED LAND CORNER RESTORATION

Index No. Y-1

State of Wisconsin

County of Oneida } ss.

I Phillip T. Hansen, do hereby

certify that on the 10th day of March, 1978, I found

evidence of the S 1/16 corner of Sections 31 & 36



Township 38, North, Range 9 & 10 East, Fourth Principal Meridian,

as described hereon; and that from this evidence I established a new monument and accessories as described hereon to perpetuate the original location of this corner.

Resident witnesses:

Jim Clafflin

Herb Wagoner

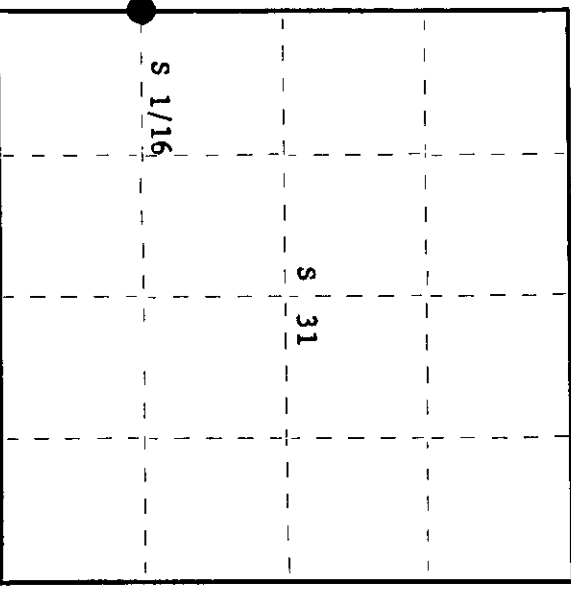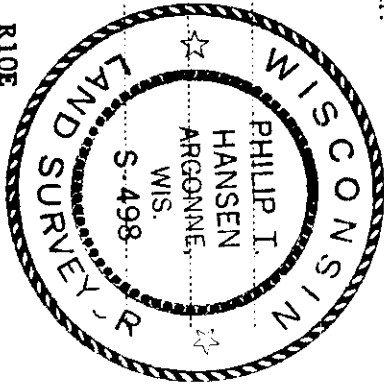

○ = Corner monument restored.

History of original corner establishment:
Corner established by N. Loftus, Ripco surveyor, in 1958.
No field note records or established BT's.

Description of corner evidence found:

- Recovered 3/4" iron pipe with 2" diameter alloy cap not stamped.
- Recovered OBT's -
- Cherry 6" S37°E, 25 links now dead, scribed S 1/16 BT.
- Balsam 7" N45°W, 34.7 links scribed S 1/16 BT.

Description of monument and accessories I established to perpetuate the original location of this corner.

- Pipe projects 8" above ground.
- NBT's -
- Maple 5" S16°E, 31.8 links
- Maple 6" N77°E, 75.7 links
- scribed 1/16 BT

Stamped alloy cap:

R9E T38N R10E
 S 1/16 36+31

Dated at Rhinelander, Wis. this 18th day of May, 1978

Signature Phillip T. Hansen Title Registered Land Surveyor Registration No. S-498
 (County Surveyor, Registered Land Surveyor, or other duly authorized official)

Office of Register of Deeds, County of Oneida. I hereby certify that the within instrument was filed in this office for record on the 2nd day of May, 1978 at 7:30 o'clock P. M.

Dorrie George Kuehn
 (Register of Deeds)

By: _____ Deputy