

CERTIFIED LAND CORNER RESTORATION

State of Wisconsin }  
County of Oneida } ss.

I James F. Kasson, do hereby certify that on the 3rd day of January, 1981, I found evidence of the East 1/4 corner corner of Section 5 Township 38 North, Range 10 East, Fourth Principal Meridian, as described hereon; and that from this evidence I established a new monument and accessories as described hereon to perpetuate the original location of this corner:

Description of original monument and accessories and subsequent restorations:

Wooden post Tamarack 12" N31E @ 7 links  
" 10" S 77 W 12 links

Description of corner evidence found:

Found old blazed line coming toward corner location from west. From Rhinelander paper co. I received copy of survey showing 1/16th corner lying to the south, and found old blazed line coming toward corner location from this 1/16th corner.


Description of monument and accessories I established to perpetuate the location of this corner:

Set 1" iron pipe over long wooden pole and drove pole into very soft bottom. Corner falls about 25' north of floating bog line in little Rice Lake.

Witnesses:

8" Balsam, S31/2°E, 351.5' this is a tree previously blazed and is the 1st blazed tree on high ground on old blazed line. I made another large blaze facing corner.

St. Regis paper co. capped iron pipe lies southerly 1336.5'.

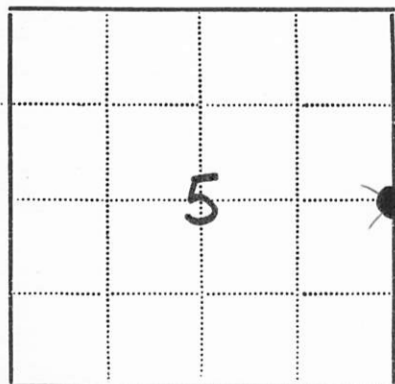

Resident witnesses.....

Dated at Rhinelander Wisconsin, this 10 day of February 1981.

Signature James F. Kasson Title RLS  
(County Surveyor, Registered Land Surveyor, or other duly authorized official)

Surveyors Registration No. 51416

Office of Peggy Deeds County of Oneida, I hereby certify that the within instrument was filed in this office for record on the 12 day of June 1980, and was filed in Book No. Page No. of County Records.

Signature Doris Verage Title Reg. of Deeds  
Cynthia A. Deeds Deputy

Township....., Range....., Section....., Index No....., Page No. 1

C-9