

CERTIFIED LAND CORNER RESTORATION

State of Wisconsin }
County of Oneida } ss.

I, James F. Kasson, do hereby certify that on the 4th day of April, 1980, I found evidence of the West 1/4 corner of Section 5 Township 38 North, Range 10 East, Fourth Principal Meridian, as described hereon; and that from this evidence I established a new monument and accessories as described hereon to perpetuate the original location of this corner:

Description of original monument and accessories and subsequent restorations:

Wooden post } Tamarack 8" S 34 E 12 links
" 8" S 28 W 20 links

Description of corner evidence found:


Wooden hub as set by surveyor Norman Loftus.

Description of monument and accessories I established to perpetuate the location of this corner:

Set 1" iron pipe to replace wooden hub.

Witnesses set:

5" Norway Pine, S60°E, 19.58' (large spike in tree)
Large spike in 5" Norway Pine, N35°E, 21.05'

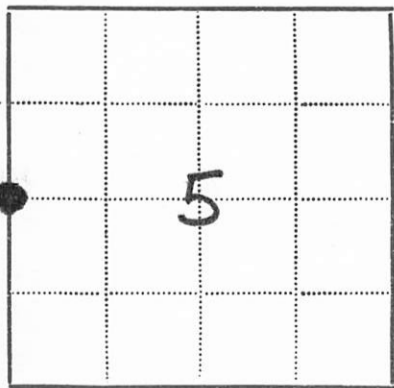

● - Corner monument restored
□ -

Resident witnesses.....

Dated at Rhinelander Wisconsin, this 10 day of February 1981.

Signature James F. Kasson Title RLS
(County Surveyor, Registered Land Surveyor, or other duly authorized official)

Surveyors Registration No. S1416

Office of Reg. of Deeds County of Oneida
I hereby certify that the within instrument was filed in this office for record on the 12 day of June 1986, and was filed in Book No. Page No. of County Records.

Signature Doris Verage Kuhn Title Reg. of Deeds
Cynthia A. Pius Deputy

Township....., Range....., Section....., Index No....., Page No.....

C-5

