

CERTIFIED LAND CORNER RESTORATION


Index No. **0-5**

State of Wisconsin

County of Oneida } ss.

I Phillip T. Hansen, do hereby certify that on the 20th day of May, 1977, I found evidence of the N 1/16 corner of Section 10 & 20 Township 38, North, Range 10 East, Fourth Principal Meridian, as described hereon; and that from this evidence I established a new monument and accessories as described hereon to perpetuate the original location of this corner.

Resident witnesses:
Jim Claffin
Herb Wagoner

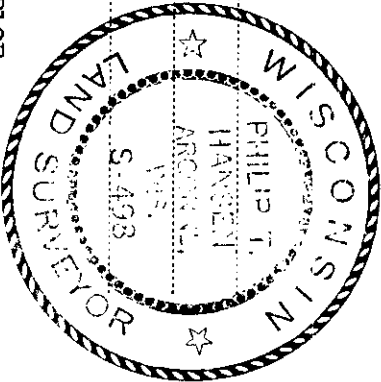


History of original corner establishment:
Corner established by N. Loftus, Ripco Surveyor, in 1954. Ran a random line from previously established NW corner of Section 20 South, a distance of 43.06 1/2, found old stake at 1/4 corner and numerous blazes, but no scribe marks. Set N 1/16 at 21.53 1/4 chains. Marked NBTs - Balsam 8" N88°W, 34 links and Balsam 6" N34°E, 27 links.

Description of corner evidence found:
Recovered 1" OD iron pipe with 2" square brass cap, stamped:
Monument sets at a fence corner with fence running North and East.
Also a 2" iron pipe setting along side the monument.
Recovered OBT - Balsam 10" N88°W, 34.9 links, scribing not legible.

T38N R10E
N 1/16
S19 1/2 S20
RIPCO

Description of monument and accessories I established to perpetuate the original location of this corner.
As monument was recovered in good condition, it was left as found.
Monument projects 24" above ground.
NBTs - Maple 5" N38°W, 68.7 links, scribed 1/16 BT.
Maple 6" S62°W, 39.5 links, scribed 1/16 BT.

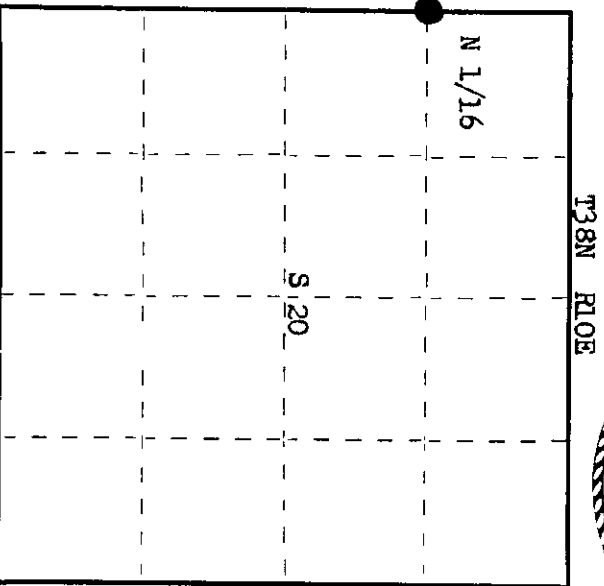

○ = Corner monument restored.

Dated at Rhineland, Wis., this 26th day of May, 1977.

Signature Phillip T. Hansen Title Registered Land Surveyor Registration No. 5-498
(County Surveyor, Registered Land Surveyor, or other duly authorized official)

Office of Register of Deeds, County of Oneida.
Instrument was filed in this office for record on the 27th day of June, 1977 at 10:30 o'clock A.M. I hereby certify that the within

Lois Verge
(Register of Deeds)

By: _____ Deputy