

State of Wisconsin

County of Oneida } ss.

I Phillip T. Hansen, do hereby certify that on the 30th day of January, 19 78, I found evidence of the NE 1/16 corner of Section 19


Township 38, North, Range 10 East, Fourth Principal Meridian,

as described hereon; and that from this evidence I established a new monument and accessories as described hereon to perpetuate the original location of this corner.


Resident witnesses:

Jim Clafflin

Herb Wagoner

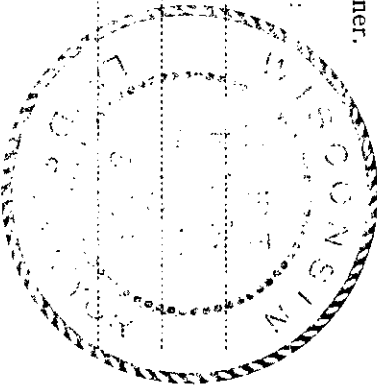

T38N R10E

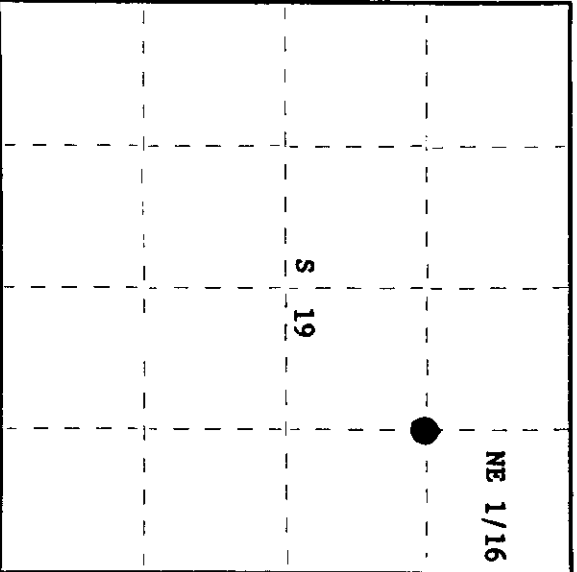

○ = Corner monument restored.

History of original corner establishment:

Corner established by N. Loftus, Ripco Surveyor, in 1956. Ran random line west from N 1/16 corner, sections 19 & 20, 40.27 chains to tie to NC 1/16 corner. Set iron pipe at 20.32 chains. Marked NBT's - White Spruce 3" S28°W, 49 links White Spruce 3" S75°E, 24 1/2 links

Description of corner evidence found:

Recovered 1" iron pipe without brass cap and a 3/4" iron pipe with 2" square brass cap in good condition. Cap stamped: Monument projects 20" above ground. Recovered White Spruce 3" (6") S28°W, 49.0 links (46.6 lks.) White Spruce 3" (6") S75°E, 24.5 links (24.2 lks.) NE 1/16 S19 RIPCO

Description of monument and accessories I established to perpetuate the original location of this corner. **Left monument in place as recovered. No additional accessories established.**

Dated at Rhinelander, Wis., this 3rd day of February, 19 78

Signature Phillip T. Hansen Title Registered Land Surveyor Registration No. S-498
(County Surveyor, Registered Land Surveyor, or other duly authorized official)

Office of Register of Deeds, County of Oneida I hereby certify that the within instrument was filed in this office for record on the 6th day of February, 19 78 at 9:35 o'clock A. M.

Terence George Kuehn
(Register of Deeds)

By Terence George Kuehn Deputy

3810193010